


KANSAS

Section 13 Township 5 Range 24W

Well No. #1 Breeden Est.


Company Empire Drlg.

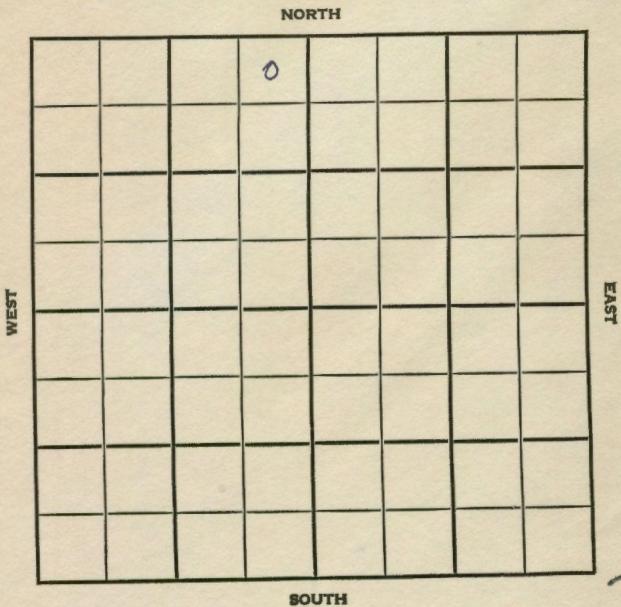

3

| | | | | | |
|------------|----------------|------|---|----|-----|
| SEC. | 13 | TWP. | 5 | R. | 24W |
| WELL NO. | 1 Breeden Est. | | | | |
| COMPANY | Empire Drlg. | | | | |
| CONTRACTOR | Empire Wildcat | | | | |

440 Ft. from N. Line
 _____ Ft. from S. Line
440 Ft. from E. Line
 _____ Ft. from W. Line

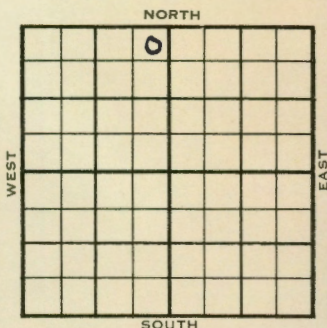

NE NE NW
Skelly-DHM

| | ELEVATION | REPORT |
|------|---|--------|
| 1954 | 2295' | |
| 8-25 | Spdg 8-18-54 8" @ 174 Heeb 3404 Tor. 3431 Lans. 3442 Drlg. 3520 | |
| 9/1 | Spud 8-18-54 D & A TD 3820 8" @ 174 Heeb 3404 Tor. 3431 Lans. 3442 B KC 3631 Arb. 3759 TD 3820 D & A | |
| | ABANDONED | |

