


Norton

KANSAS

Section 13 Township 5 Range 24 WWell No. #1 Moore "B"Company Jones, Shelburne & Farmer

NORTH

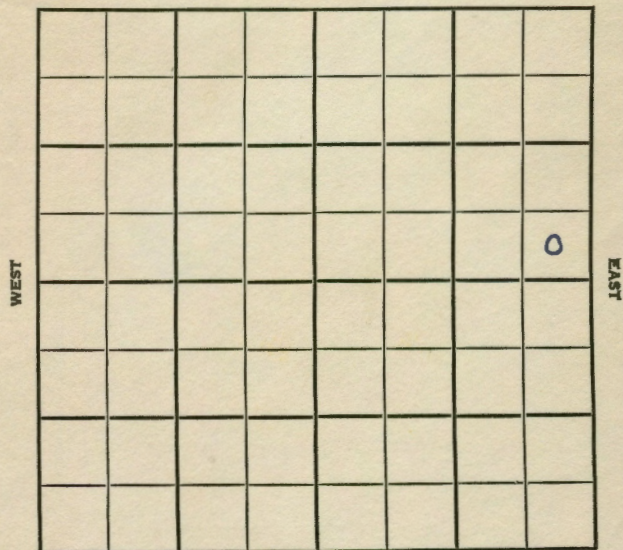

SOUTH

8

SEC.	TWP.	R.
13	5	24W

WELL NO. #1 Moore "B" FARM

COMPANY Jones, Shelburne & Farmer

CONTRACTOR Col. Tools

WILDCAT


_____ Ft. from N. Line

_____ Ft. from S. Line

_____ Ft. from E. Line

_____ Ft. from W. Line

SE SE NE

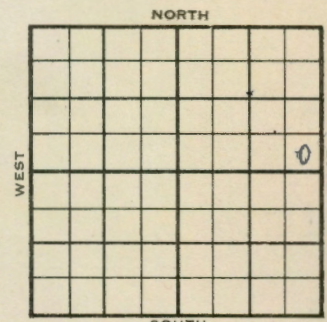

Backus Oil - DHM

1956	ELEVATION	REPORT
	2307	

3-14
3/28

MIR

Comm 3-13-56

Anh

1912

H

3426

3426

Tr

3442

3442

L

3462

3464

BKC

3650

3650

C

3809

3809

A

3839

3842

TD

3878

8 5/8" @ 235/125

D & A

ABANDONED

County	Norton			Elev.	
Sec.	13	Twp.	5	Rge.	24W
Company	Jones, Shelburne & Farmer				
FarmName	Moore "B"			No.	1

TOPS	DEPTH	LOG	DATUM	Loc. in Sec.
Anh.				SE SE NE
Tr.				
H.				
Tr.				
Dg.				
BL.				
L.				
K.C.				Geol.
B.K.C.				Contr.
Ce.				Co. tools
C.				
M.				
M.				
K.				Pool
Mz.				Wildcat
Me.				
V.				
S.				
S.				
A.				
R.				
Pe.				
G.				
T.D.				

DATE REPORT
MAR 24 1956

MAR 14 1956

Date Comm.

M I R

Backus Oil & DHM

County	Norton			Elev.	2307
Sec.	13	Twp.	5	Rge.	24W
Company	Jones, Shelburne & Farmer				
FarmName	Moore "B"			No.	1

TOPS	DEPTH	LOG	DATUM	Loc. in Sec.
Anh.	1912			SE SE NE
Tr.				
H.	3426	3426		
Tr.	3442	3442		
Dg.				
BL.				
L.	3462	3464	1157	Geol.
K.C.	3650	3650	1343	Contr.
Ce.	3809	3809	1502	Co. tools
C.				
M.				
M.				Pool
K.				Wildcat
Mz.				
Me.				
V.				
S.				
S.				
A.	3839	3842	1535	ABANDONED
R.				
Pe.				
G.				
T.D.	3878			

DATE REPORT
MAR 28 1956

Date Comm.

8 5/8" @ 235/125

D & A