


Section 16 Township 5 Range 21WWell No. #1 BarboCompany Sauvage & Dunn

NORTH

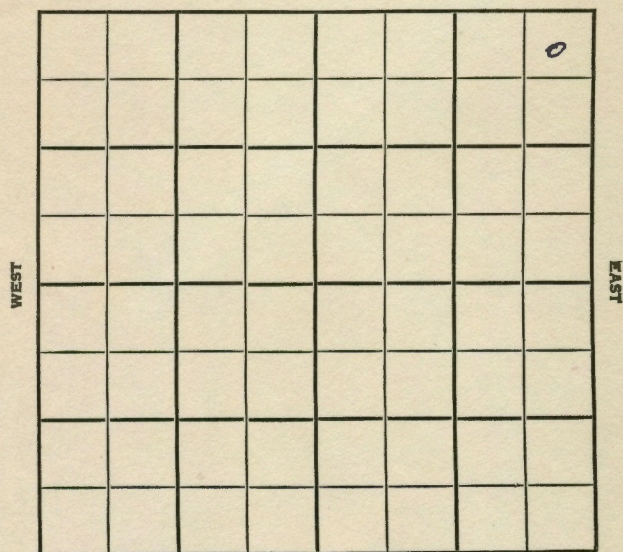

SOUTH

SEC. 16 TWP. 5 R. 21W

WELL NO. 1 Barbo FARM

COMPANY Sauvage & Dunn

CONTRACTOR Co. Tools

Wildcat

330 Ft. from N. Line


Ft. from S. Line

330 Ft. from E. Line

Ft. from W. Line

NE NE NE

NORTH

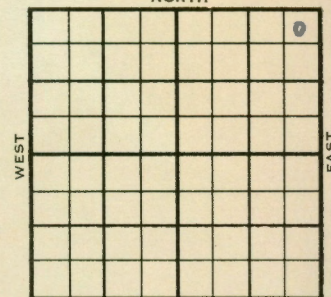

SOUTH

1955

ELEVATION

2366'

REPORT

2/23
3/16

MIR
 Spud 2-24-55 D&A TD 3925
 8" @ 165 Anhy 1980, Heeb 3405,
 Tor. 3498, Lans 3513
 DST 3525-60 open 45 min. Rec
 50' mud 900#, B kc 3702,
 Arb. 3893, TD 3925
 D&A

ABANDONED

FABEN GILSTRAP