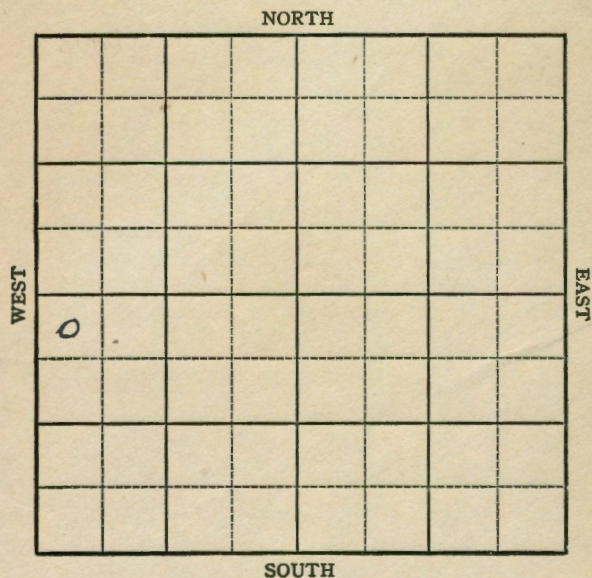


Decatur

KANSAS

Section 20 Township 5 Range 26WWell No. #1 BaderCompany Herndon Drlg.

12

Decatur

KANSAS

Sec. 20 Twp. 5 R. 26WWell No. #1 Bader FarmHerndon Drlg. Company

Contractor


330' Wildcat
Ft. from N. Line

Ft. from S. Line

Ft. from E. Line

330' Ft. from W. Line

NW NW SW

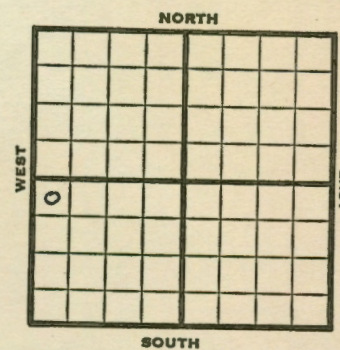

1951

Elev. 2632' REPORT

5/29

Location

6/20

Spud 6-1-51
D&A TD 4255
8" @ 250Anhy 2225 KC 3691
DST 3766-3801 opn 1 hr
Rec. 90' mud & wtr
Cong 4018 Cong. 4088
Arb. 4161 TD 4255
D&A**ABANDONED**

County Decatur State Kansas
 Sec. 20 (Blk. 5 (Sur. 26W Map No.
 (Twp.)
 Operator Herndon Drlg.
 Well No. 1 Farm Bader
 Elev. 2632 Location NW NW SW



330 Ft. From N Line SW
330 Ft. From W Line Quarter

1st. Report

Completion JUN 20 1951

Remarks Wildcat

Spudding Date 6-1-51

Drlg. Data D & A TD 4255

8" @ 250 Anky 2225 KC 3691 DST 3766-


3801 open 1 hr. Rec. 90' mud & water

Cong. 4018 Cong. 4088 Arb. 4161

TD 4255 D & A

J. E. TYRA

County Decatur State Kansas
 Sec. 20 (Blk. 5 (Sur. 26W Map No.
 (Twp.)
 Operator Herndon Drlg.
 Well No. 1 Farm Bader
 Elev. Location NW NW SW

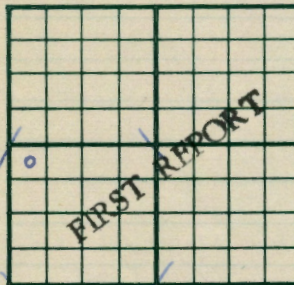

330 Ft. From N Line SW

330 Ft. From W Line Quarter

1st. Report MAY 29 1951

Completion

Remarks

Spudding Date

Drlg. Data

Wildcat

Location

J. E. TYRA