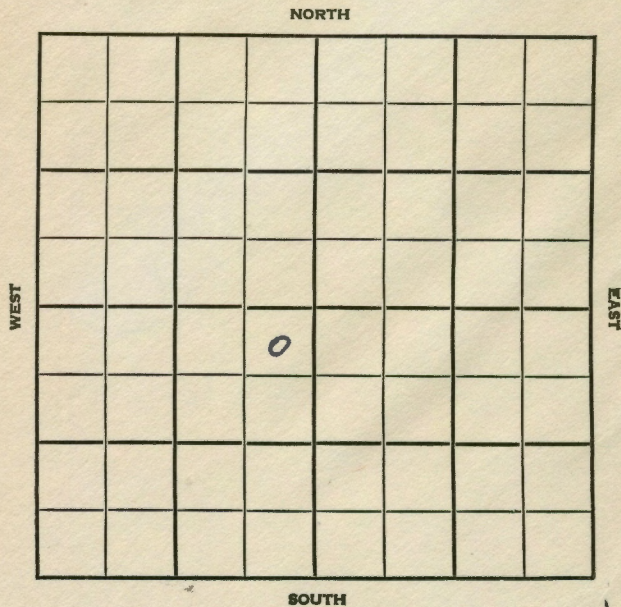


Section 10 Township 5 Range 26WWell No. 1 ShimekCompany Jones, Shelburne & Farmer

11

SEC. <u>10</u>	TWP. <u>5</u>	R. <u>26W</u>
WELL NO. <u>#1 Shimek</u>		
FARM		
COMPANY <u>Jones, Shelburne & Farmer</u>		
CONTRACTOR		


Wildcat.

330 Ft. from N. Line

_____ Ft. from S. Line

330 Ft. from E. Line


_____ Ft. from W. Line

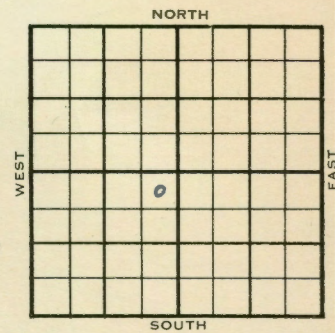

NE NE SW

1955	ELEVATION <u>2631'</u>	REPORT
1/26 2/9	Location Spud 1-26-55 D & A TD 4134' 8" @ 260' Heeb 3654', Tor 3677' Howard. 3384 Top 3436', Lans 3695' B KC 3887' Arb. 4107' Schlumberger Tops: Heeb 3654' Tor 3678' Lans 3694' B KC 3882' Shy Arb. 4107' Arb. 4125' TD 4134' D & A	
ABANDONED		

County Decatur State Kansas
 Sec. 10 (Blk. 5 (Sur. 26W Map No.
 Operator Jones, Shelburne & Farmer
 Well No. 1 Farm Shimek
 Elev. 2631 Location NE NE SW

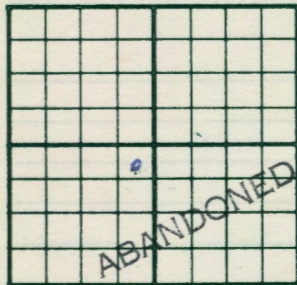

330 Ft. From N Line SW
330 Ft. From E Line Quarter

1st. Report

Completion FEB 9 1955

Remarks Wildcat

Spudding Date 1-26-55

Drig. Data D & A TD 4134

8" @ 260 Heeb. 3654 Tor. 3677

Howard 3384 Top. 3436 Lans. 3695

B KC 3887 Arb. 4107 SCHLUMBERGER TOPS:

Heeb. 3654 Tor. 3678 Lans. 3694


B KC 3882 Shy. Arb. 4107 Arb. 4125

TD 4134

D & A

FABEN GILSTRAP

County Decatur State Kansas
 Sec. 10 (Blk. 5 (Sur. 26W Map No.
 Operator Jones, Shelburne & Farmer
 Well No. 1 Farm Shimek
 Elev. Location NE NE SW

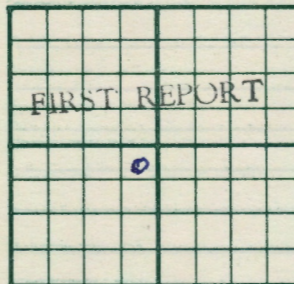

330 Ft. From N Line SW

330 Ft. From E Line Quarter

1st. Report JAN 2 6 1955

Completion

Remarks

Spudding Date

Drig. Data

Wildcat

Location

FABEN GILSTRAP