


Section 1 Township 5 Range 27W

Well No. #1 Carter

Company R. W. Shields

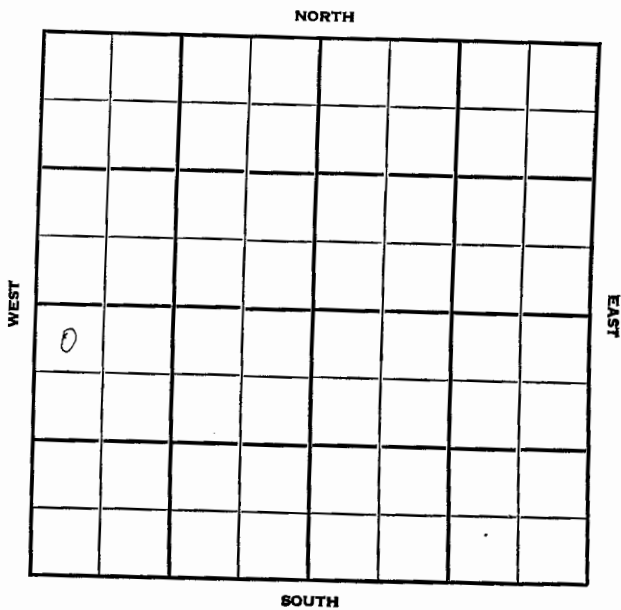

12

SEC. 1 TWP. 5 R. 27W

WELL NO. #### #1 Carter FARM

COMPANY R. W. Shields

CONTRACTOR Barnett

WILDCAT


_____ Ft. from N. Line

_____ Ft. from S. Line

_____ Ft. from E. Line

_____ Ft. from W. Line

NW NW SW

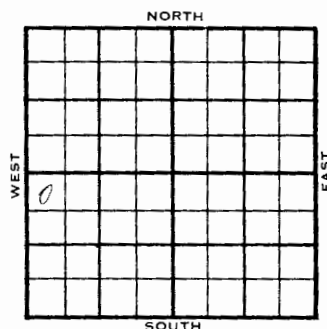

Continental - FO

1956 ELEVATION 2640 REPORT

3-21 MIR

4-4- Comm. 3-21-56
 8 5/8" @ 240 w/175
 DST 3604-34 op 1 1/2 hr. rec. 180' socw
 1090/30"
 DST 3632-48 op 1 1/2 hr. rec. 270' wtr.
 1150/30"
 D & A
 E. 3561
 L. 3600
 BKC 3791
 TD 3808'

ABANDONED

County **Decatur** Elev. _____
 Sec. **1** Twp. **5** Rge. **27W**
 Company **R. W. Shields**
 FarmName **Carter** No. **1**

TOPS	DEPTH	LOG	DATUM	Loc. in Sec.
Anh.				NW NW SW
TP.				
H.				
Tr.				
Dg.				
Bl.				
L.				Geol. _____
K.C.				Contr. _____
B.K.C.				Barnett
Ce.				
C.				Pool _____
M.				Wildcat
Mz.				
Me.				
V.				
S.				
A.				
R.				
PE.				
G.				
TD.				

FIRST REPORT
 MAR 21 56

Date Comm. **Continental PO**
M I R

33

County **Decatur** Elev. **2640**
 Sec. **1** Twp. **5** Rge. **27W**
 Company **R. W. Shields**
 FarmName **Carter** No. **1**

TOPS	DEPTH	LOG	DATUM	Loc. in Sec.
Anh.				NW NW SW
TP.				
H.	3561		921	
Tr.				
Dg.				
Bl.				
L.	3600		960	Geol. _____
K.C.	3791		1151	Contr. _____
B.K.C.				Barnett
Ce.				
C.				Pool _____
M.				Wildcat
Mz.				
Me.				
V.				
S.				
A.				
R.				
PE.				
G.				
TD.	3808			

ABANDONED
 APR 4 56

Date Comm. **3-21-56**

8 5/8" @ 240/175 DST 3604-34 open 1 1/2 hr
rec. 180' socw & m 1090/30"
DST 3632-48 open 1 1/2 hr. rec. 270' wtr.
1150/30"

D & A