



DX 78-1

SEC. 2 TWP. 5 R. 27W  
 WELL NO. 3 C. E. Feely FARM  
 COMPANY Conoco  
 CONTRACTOR

Section 2 Township 5 Range 27W  
 Well No. 3 C. E. Feely  
 Company Conoco

Nye & Snell  
 Feely Pool

\_\_\_\_\_ Ft. from N. Line  
 1650 \_\_\_\_\_ Ft. from S. Line  
 \_\_\_\_\_ Ft. from E. Line  
 2310 \_\_\_\_\_ Ft. from W. Line

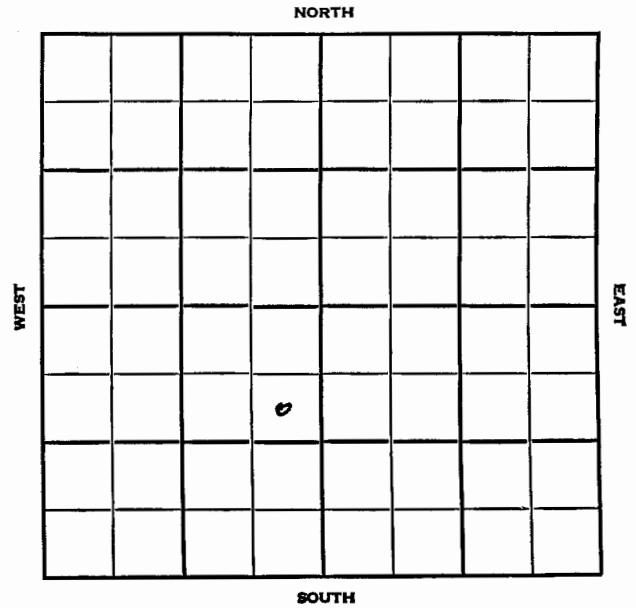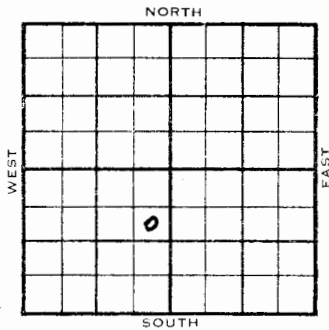

C SE NE SW

1954	ELEVATION 2650 2654 RB	REPORT
6/8	9" @ 268	Lans-KC test
	Drlg. 2510	
6/23		Drlg. 2510'
7/28	Spud 6-5-54 Oil well TD 3820'	
	9" @ 268 "why 2210 Lans 3620	
	DST 3621-35 open 1 hr rec 15' OCM 680#	
	DST 3645-72 open 1 hr rec 700' gas 15' free oil, 48' OCM 140#	
	DST 3694-3707 open 1 hr rec 1230' SW 590#	
	DST 3787-3800 open 1 hr rec 15' mud 0#	
	TD 3820 5" @ 3819 CO to 3789	
	48/3619-31 250 A S/1 BOPH 3 hr.	
	20/3644-49 48/3657-69 250 A	
	S/3/4 BO 3 hr. 1000 A S/3 BO 1 hr. Marm 3814 S/2 BO 4 hr.	
	S/9 BO 4 1/2 BW 9 hr.	
	Comp. 5 BOPD 11 BW	
	<b>COMPLETED</b>	

11

