


(Mail to Kansas Geological Survey, 4150 Monroe Street, Wichita, Kansas 67209)

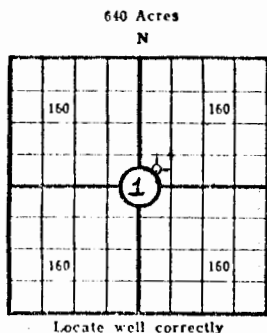

Lease Name: Tacha Well No. 1
Well Located: Decatur County
SW SW NE SEC 1 TWP 5S RGE 27W
Operator: Murfin Drilling Company
Address: 617 Union Center, Wichita, Kansas 67202
Elevation: Ground 2596 D.F. K.B. 2601
Type Well: (Oil, gas, dry hole) Dry Hole

Drilling Commenced: 10-2 1971 Drilling Completed: 10-15 1971
Well Completed: 10-15 1971 Total Depth 3745
Initial Production:

Casing Record

Size: 8 5/8 Set at 230' Size: _____ Set at _____
Size: _____ Set at _____ Size: _____ Set at _____

Liner Record

Size: _____ Set from _____ To _____

Cementing

<u>Casing Size</u>	<u>Sacks</u>	<u>Type Cement and Additives</u>
<u>8 5/8</u>	<u>175</u>	<u>Comm</u>
<u> </u>	<u> </u>	<u> </u>
<u> </u>	<u> </u>	<u> </u>

Perforations

<u>Formation</u>	<u>Perforated Interval and Number Shots</u>

Electric Log Run (Show type log and depths covered)

NO LOG

Formation	Top	Bottom	Show Drill Stem Tests, Well Stimulation and Production Tests
			Dst #1 3212-24, 15-30-15-30, Rec 5' Mud, FP 18-23#, ISIP 792#, FSIP 703# Dst #2 3540-90, 30-30-60-30, Rec 120' Sl OCM, FP 36-90#, ISIP 999#, FSIP 918# Dst #3 3590-3610, 30-30-30-30, Rec 10' M, sl os, FP 18-27#, ISIP 108#, FSIP 54# Dst #4 3610-60, 30-30-30-30, Rec 2130' Gsy Sl OCSW, FP 126-954# ISIP 1062#, FSIP 1062# Dst #5 3660-3745, 30-30, Rec 10' M FP 45-63#, ISIP 99# 180 Clay & Sand 1795 Shale 1923 Sand 2133 Shale 2166 Anhydrite 2645 Shale 3035 Lime & Shale 3224 Lime 3585 Lime & Shale 3745 Lime SNP Depo Anhy 2133 B Anhy 2166 Neva 2924 Wal 3028 Dark fm 3214 How 3311 Top 3328 Hill 3508 Var 3534 AKC 3548 BKC 3737 J.D. 3745