


Section 2 Township 5 Range 27W

Well No. #1 C. E. Feely

Company Continental Oil

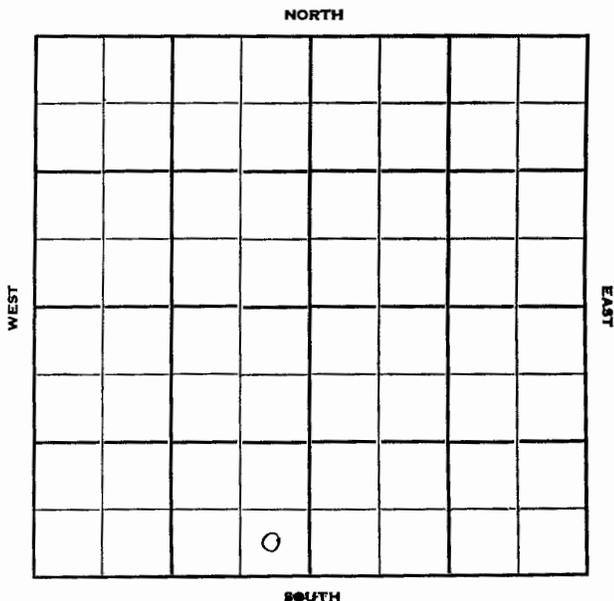

Sec. 2 Twp. 5 R. 27W

Well No. #1 C. E. Feely Farm

Company Continental Oil Company

Contractor Long & Johnson

Wildcat


..... Ft. from N. Line

330 Ft. from S. Line

330 Ft. from E. Line

..... Ft. from W. Line

SE SE SW

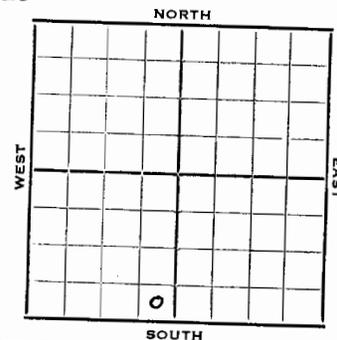

1952 Elev. 2618' REPORT

4/9 Spud 4-5-52
10" @ 256'
Drlg. 1800'

4/23 TD 4042' 5" @ 3710'
Schl tops: Topeka 3371' Heeb 3550'
Lans. 3591' Marm 3786' Arb. 3987'

4/30 PB 3677 24/3652-60 B/trace oil &
1/2 BWFH 250 A S/5 BO & 100 BW
2 hrs. Set retainer 3640

5/7 e1/ 3628-39 B/ 1 gal oph 24/ 3616-24
S/ 20 boph for 16 hrs. set plug 3608
42/ 3590-3604 S/ 2 boph for 12 hrs.
250 A S/ 20 boph for 4 hrs.
tub & rods.

5/13 Spud 4-5-52 Oil Well TD 4042
10" @ 256 Anhy 2180 Heeb. 3550
Lans. 3591 DST 3588-3603 opn 1 hr.
Rec. 15' ocm DST 3603-30 opn 1/2 hr.
Rec. 1080' oil DST 3656-82 opn 1 hr.
Rec. 1200' sw DST 3690-3710 opn 1 hr.
Rec. 337' sw TD 4042 5" @ 3710
Top. 3371 Marm. 3786 Arb. 3987
PB 3677 24/3652-60 B/tr. oil
1/2 bwph B/tr. oil 1/3 bwph 250 A
S/5 bo 100 bw 7 hr. SP 3640
31/3628-39 B/1 gwph 24/3616-24
S/20 boph 16 hr. SP 3608
42/3590-3604 S/2 boph 12 hr.
S 20 boph 4 hr. Comp. 254 bond

REPRODUCED

Orig. Data

S/ 20 bopd 4 hr. Comp. 254 bopd

SCOUT CARDS
LAND SHIRT MAP
LAND WALL MAP
TRONTS
FRANCE MAP
PIECE MAP
MISC.

APR 21 1982