


Section 11 Township 5 Range 27W

Well No. #1 Koerperich

Company R.W. Shields

NORTH

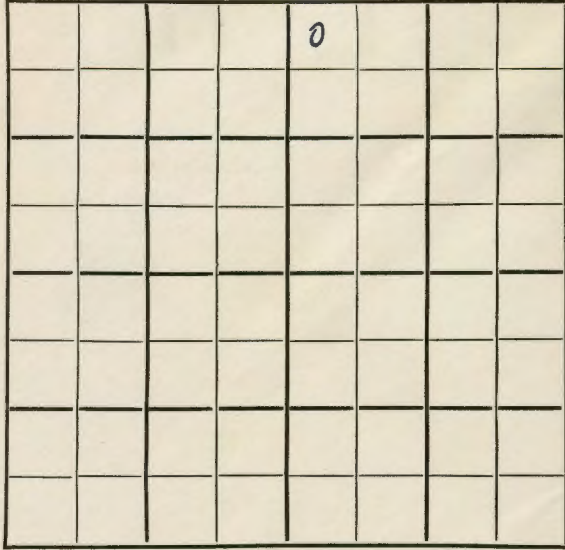

SOUTH

2

SEC. 11 TWP. 5 R. 27W

WELL NO. #1 Koerperich FARM

COMPANY R.W. Shields

CONTRACTOR

Feeley Pool


330 Ft. from N. Line

\_\_\_\_\_ Ft. from S. Line

\_\_\_\_\_ Ft. from E. Line

330 Ft. from W. Line

NORTH

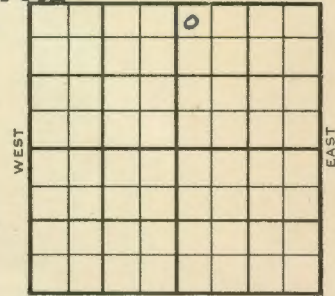

SOUTH

NW NW NE  
Conoco F/O

	ELEVATION	REPORT
1954	2645'	
4/7	Spud 4-2-54 8" @ 243' Drlg 990'	
4/14	Drlg. 990'	
6/23	Spud 4-2-54 Oil Well TD 3840' 8" @ 243' Heeb 3580', Lans 3618' DST 3610-54, SI 20", rec. 6' socm, tr free oil, 60' vsocm, 145# DST 3634-66', opnl hr., SI 30", rec. 100' ocm, 675# TD 3840 B KC 3815' 5" @ 3690' 19/3660-68, 2 1/2 boph 500A 12/3650-54, FU 290' oil 1 hr., 300A CO to 3840 S/2 boph Comp. 32 bopd	

COMPLETED

