

KANSAS

Decatur

Decatur KANSAS

Section 2 Township 5 Range 27 W

SEC. 2 TWP. 5 R. 27W

Well No. #1 Feely "A" → Feely Lansing KC



WELL NO. #1 Feely "A" → Feely Lansing KC FARI

Company R. W. Shields

COMPANY R. W. Shields Unit 4 - KCC

CONTRACTOR

Barnett
Feely

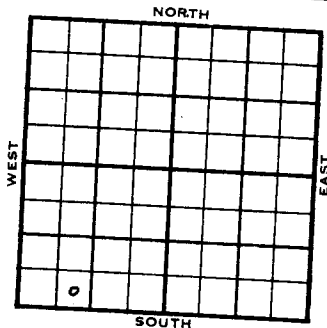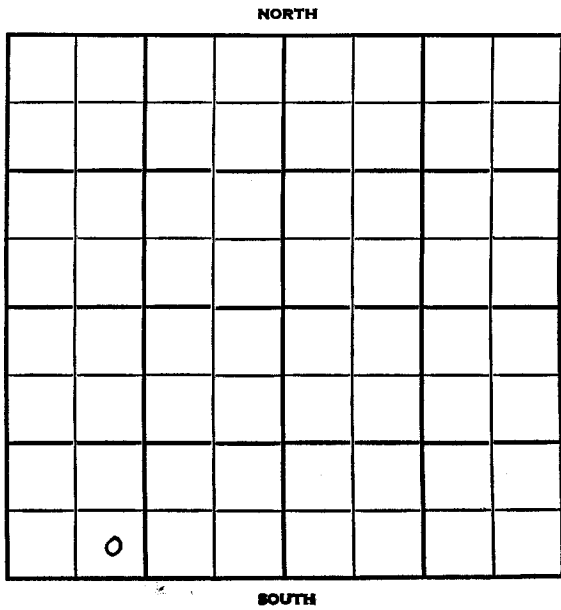

_____ Ft. from N. Line
 _____ Ft. from S. Line
 _____ Ft. from E. Line
 _____ Ft. from W. Line

SE SW SW

Cont'l - DHM

	ELEVATION	REPORT
1955	2617'	
10/5		Comm 10-2-55 8" @ 200/175 DrLg 1000
11-16		DST 3585-3615 op 1/2 hr. rec 5' mud, 1140/30". DST 3607-42 op 1 1/2 hr. 2000' GIP, rec. 215' gassy oil 120' mco, 290/30" 5 1/2" @ 3717, CO to 3693, 24/ 3630-38 B/ 2 gwph, 500 A, S/ 4.2 bwph 9 hr. SP 3632 18/ 3618-24, S/ 4.20 boph 1000 A, S/ 6 boph, SP 3613, 18/ 3596- 3600, 500 A, S/ 6 boph, CO to 3693 S/ 12 1/2 boph 1 hr. # Comp. 123 bopd. Tops: H. 3554' L. 3593 TD 3717'.

COMPLETED

13

County **Decatur** Elev. _____
Sec. **2** Twp. **5** Rge. **27W**
Company **R. W. Shields**
Farm Name **Feely "A" - Feely Langs. No. 1**
KC Unit 4-KCC

TOPS	DEPTH	LOG	DATUM	Loc. in Sec.
				SE SW SW

Geol. _____
Contr. **Barnett**
Pool **Feely**

OCT 5 55
FIRST REPORT

Date Comm. **10-2-55** Cont. **1 DEN**
200/175 drlg. 1000

B

County **Decatur** Elev. **2617**
Sec. **2** Twp. **5** Rge. **27W**
Company **R. W. Shields**
Farm Name **Feely "A" - Feely Langs. No. 1**
KC Unit 4 (KCC)

TOPS	DEPTH	LOG	DATUM	Loc. in Sec.
				SE SW SW

Geol. _____
Contr. **Barnett**
Pool **Feely**

COMPLETE

Date Comm. **10-2-55** **NOV 1 6 1955**
8" @ 200/175 DST 3585-3615 open 1/2 hr.
rec. 5' mud 1140/30" DST 3607-42
open 1 1/2 hr. 2000' GIP rec. 215' gassy
oil 120' mco 290/30" 5 1/2" @ 3717
CO to 3693 24/ 3630-38 B/ 2 gwph
500 A S/ 4.2 bwph 9 hr. SP 3632
18/ 3618-24 S/ 4.20 boph 1000 A
S/ 6' boph SP 3613 18/ 3596-3600

County Deeatur		Elev.
Sec. 2	Twp. 5	Rge. 27W
Company R. W. Shields		
Farm Name Foaly "A" - PEMY Lansing No. 1		
KC Unit 4-KCC		
TOPS	DEPTH	LOG DATUM
Loc. in Sec.	SE SW 31	
Geol.		
Contr.	Barnett	
Pool	Foaly	
Co.		
C.		
M.		
N.		
K.		
Mz.		
Me.		
V.		
S.		
A.		
R.		
PC.		
G.		
EA.		
ic Comm.	10-2-55	Cont 1 DEN
# 200/175	drlg. 1000	

500 A S/ 6 boph CO to 3693 S/ 12 1/4 bop
1 hr. Comp. 123 bopd

.....	Misc.
.....	Pierce Map
.....	France Map
.....	Tracings
.....	Land Wall Map
.....	Land Small Map
.....	Scout Cards

NOV 25 1955