


DX 78-1 Decatur

KANSAS

Section 3 Township 5 Range 27W

Well No. #1 Dodson

Company Jones, Shelburne & Farmer

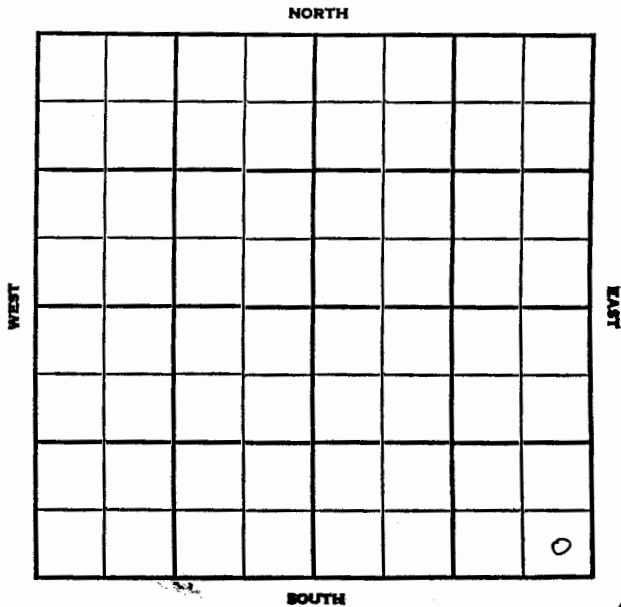

16

Decatur KANSAS

SEC. 3 TWP. 5 R. 27W

WELL NO. #1 Dodson FAR

COMPANY Jones, Shelburne & Farmer

CONTRACTOR

Feely


_____ FT. FROM N. LINE

_____ FT. FROM S. LINE

_____ FT. FROM E. LINE

_____ FT. FROM W. LINE

SE SE SE

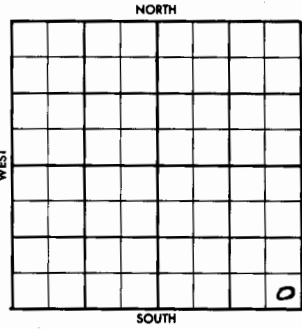

$\frac{1}{2}$ mile - SDX

1956	ELEVATION	REPORT
	2580'	

- 8-8 MIR
- 8-16 Spud 807-56
8 5/8" @ 161 w/135
Anhy 2160'
Drlg. 3360'
- 8-22 DST 3563-85 op 30 min. red. 12' mud,
BHP 230/20".
DST 3603-25 op 30 min. rec. 10' mud,
BHP 300/20".
DST 3650-55 failed.
DST 3644-65 op 1 hr., rec. 140' MW,
/ 180' SW, 1140/20".
No log
D & A
H. 3537'; Tr. 3562'; L. 3579';
BKC 3778';
TD 3785'

ABANDONED

County Decatur Elev. 2580
 Sec. 3 Twp. 5 Rge. 27W
 Company Jones, Shelburne & Farmer
 Farm Name Dodson No. 1

	DEPTH	LOG	DATUM	Loc. in Sec.
Ap.	2140			SE SE SE
H.	3537			
Tr.	3502			
Dg.				
Bl.	3577			Geol.
L.				Contr.
N.C.	3778			
B.N.C.				
Ce.				
C.				
M.				Pool
K.				Feely
Mz.				
Me.				
V.				
S.				
A.				
R.				
PE.				
G.				
TD.	3785			

ABANDONED
 1/2 mile

AUG 22 1956

Date Comm. M I R AUG 15 56 8-7-56 85/8
121/135 3360 AUG 22 56
DST 3562-85 30" acc 12' M
BHP 230/20 DST 3603-25
30" acc 10' Md (550) BHP
300/20" DST 3650-55 F3110
DST 3644-65 1hr acc 140'
MW +180' SW 1140/20"
No Log DE 2

County Decatur Elev. 27W
 Sec. 3 Twp. 5 Rge. 27W
 Company Jones, Shelburne & Farmer
 Farm Name Dodson No. 1

TOPS	DEPTH	LOG	DATUM	Loc. in Sec.
Anh.				SE SE SE
Tr.				
H.				
Tr.				
Dg.				
Bl.				
L.				Geol.
N.C.				Contr.
B.N.C.				
Ce.				
C.				
M.				Pool
M.				Feely
K.				
Mz.				
Me.				
V.				
S.				
S.				
A.				
R.				
PE.				
G.				
TD.				

FIRST REPORT
 1/2 mile

AUG 8 '56

Date Comm. M I R

3/3
R.G.