

Decatur KANSAS


DX 78-1

Section 3 Township 5 Range 27W

Well No. 1 Dodson

Company W. W. Sauvage

NORTH

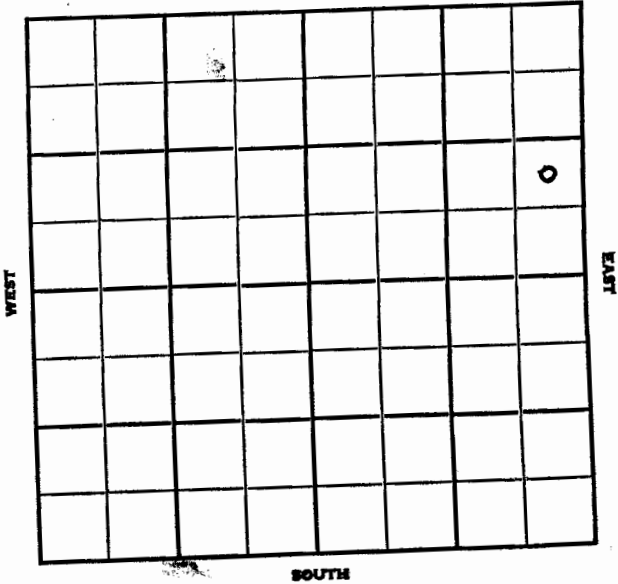

SOUTH

8

Decatur KANSAS

SEC.	TWP.	R.
3	5	27W

WELL NO.

1 Dodson FARM

COMPANY

W. W. Sauvage

CONTRACTOR

Semi Wildcat


Ft. from N. Line

990 Ft. from S. Line

330 Ft. from E. Line

Ft. from W. Line

NORTH

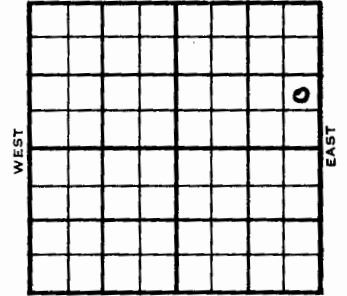

SOUTH

NE SE NE

1954	ELEVATION	REPORT
	2631'	

7/21 Spdg 7-18-54
 8" @ 300
 Drlg. 1614

7/28 Spud 7-18-54 D & A TD 3830
 8" @ 300 Heeb 3584 Lans 3623
 TD 3830' D & A

ABANDONED

DX-78

