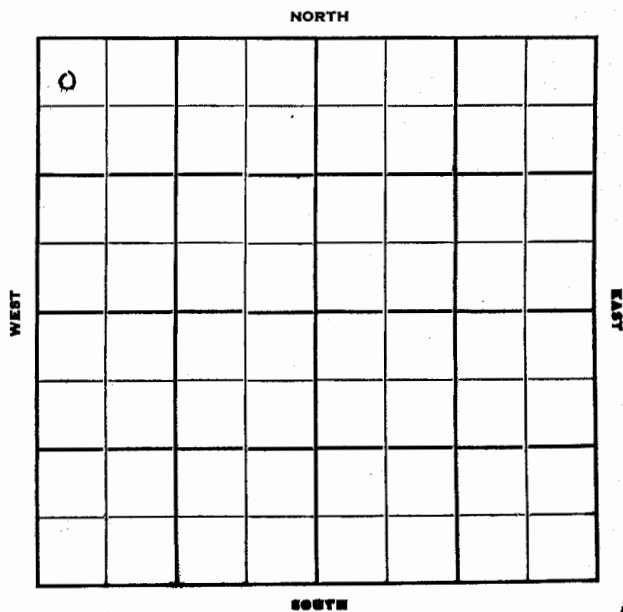


Section 8 Township 5 Range 27WWell No. #1 GreenCompany Pack Oil Co.Sec. 8 Twp. 5 R. 27 W ☒ KANSASWell No. #1 Green Farm

Pack Oil Co. Company

Impire Drlg. Contractor


Wildcat

330 Ft. from N. Line

Ft. from S. Line

Ft. from E. Line

330 Ft. from W. Line

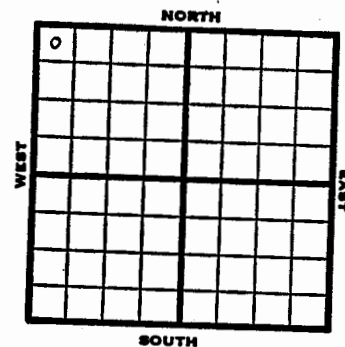NW NW NW
Shell DHM

1951 Elev. 2670' REPORT

8/15 Location

10/3 Spud 9-18-51

D & A TD 4418' 8" @ 285'
 Top 3627' Heeb 3858' Tor. 3887'
 Lans. 3904'
 DST 3912-90' open $\frac{1}{2}$ hr. rec 20' mud
 B KC 4111' Cong 4389' Miss 4403'
 TD 4418' D & A

ABANDONED

County Decatur State Kansas
 Sec. 8 (Blk.) 5 (Sur.) 27W Map No.
 Operator Pack Oil Co.
 Well No. 1 Farm Green
 Elev. 2670 Location NW NW NW

0					

330 Ft. From N Line NW
330 Ft. From W Line Quarter
 Ist. Report
 Completion OCT 3 1951
 Remarks Wildcat
Impire Drlg. - Contr.
 Spudding Date 9-18-51

Drlg. Data D & A TD 4418
8" @ 285 Top. 3627 Heeb. 3858
Tor. 3887 Lans. 3904 DST 3912-90
open $\frac{1}{2}$ hr. Rec. 20' mud B KC 4111
Cong. 4389 Miss. 4403 TD 4418
D & A

J. E. TYRA

County Decatur State Kansas
 Sec. 8 (Blk.) 5 (Sur.) 27W Map No.
 Operator Pack Oil Co.
 Well No. 1 Farm Green
 Elev. Location NW NW NW

0					

330 Ft. From N Line NW
330 Ft. From W Line Quarter
 Ist. Report AUG 15 1951
 Completion
 Remarks Shell DNM
 Spudding Date

Drlg. Data Wildcat
Location

J. E. TYRA