

Section 11 Township 5 Range 27W

Sec. 11 Twp. 5 R. 27 W

Well No. #1 Clarence Seely

Well No. # 1 Clarence Seely Farm

Company Empire Drlg.

Empire Drlg. Company

Empire Contractor

Wildcat



..... Ft. from N. Line

330 Ft. from S. Line

..... Ft. from E. Line

330 Ft. from W. Line

SW SW SE

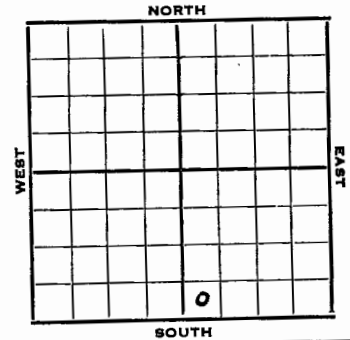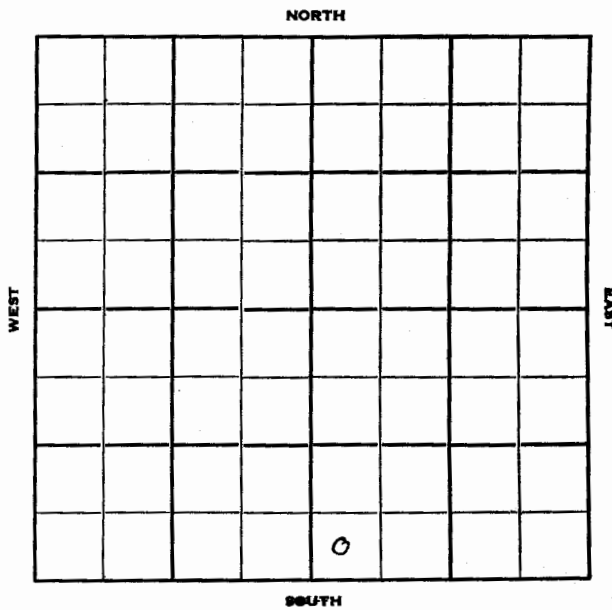

1952	Elev. 2660'	REPORT
4/2		Cellar & pits
4/9		8" @ 254' Drlg. 3600'
4/16		Spud 4-3-52 D & A TD 4115' 8" @ 254' Top 3445' Heeb 3615' Tor. 3639' Lans. 3653' DST 3668-95 open 20 min, rec 540' SW DST 3788-3840' open 1/2 hr. rec 10' mud Arb. 4064' TD 4115' D & A
ABANDONED		

County **Decatur** State **Kansas**
 Sec. **11** (Blk. Twp.) **5** (Sur. Rge.) **27W** Map No.
 Operator **Empire Drlg.**
 Well No. **1** Farm **Clarence Seely**
 Elev. **2660** Location **SW SW SE**

330 Ft. From **S** Line **SE**
330 Ft. From **W** Line **Quarter**
 Ist. Report
 Completion **APR 16 1952**
 Remarks **Wildcat**
Empire - Contr.
 Spudding Date **4-3-52**

Drlg. Data **D & A TD 4115**
8" @ 254 Top. 3445 Heeb. 3615
Tor. 3639 Lans. 3653 DST 3668-95
open 20 min. Rec. 540' sw DST 3788-3840
open $\frac{1}{2}$ hr. Rec. 10' mud Arb. 4064
TD 4115

D & A

J. G. McGEHEE

County **Decatur** State **Kansas**
 Sec. **11** (Blk. Twp.) **5** (Sur. Rge.) **27W** Map No.
 Operator **Empire Drlg.**
 Well No. **1** Farm **Clarence Seely**
 Elev. Location **SW SW SE**

330 Ft. From **S** Line **SE**
330 Ft. From **W** Line **Quarter**
 Ist. Report **APR 2 1952**
 Completion
 Remarks **Empire - Contr.**
 Spudding Date

Drlg. Data **Wildcat**
Cellar & pits

J. G. McGEHEE