


WELL LOG BUREAU—KANSAS GEOLOGICAL SOCIETY
 503 East Murdock, Wichita, Kansas

11-5-27W

Company- R. W. SHIELDS
 Farm- Koerperich "B" No. 1

SEC. 11 T. 5 R. 27W
 C N/2 NW NW

Total Depth. 3700'
 Comm. 4-15-57 Comp. 4-22-57
 Shot or Treated.
 Contractor. Barnett Drilling, Inc.
 Issued. 5-11-57

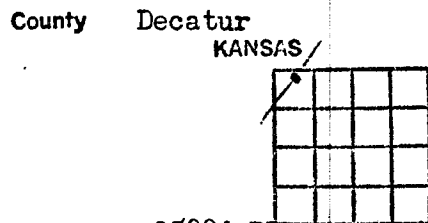

CASING:

8 5/8" @247' w/175 sx cem.

Elevation. 2588' RB

Production. Dry

Figures indicate Bottom of Formations.

shale	35
sand	60
shale & sand	180
shale & shells	700
sand & shale	815
shale & shells	1115
sand & shale	1300
shale & shells	1820
sand	1930
shale	2158
Anhydrite	2195
shale	2265
shale & shells	2510
shale	2910
lime	3020
lime & shale	3115
lime	3235
shale & lime	3320
lime	3700

Total Depth

SCOUT TOPS

Heebner	3529
Lansing	3572