


Decatur

KANSAS

SECTION 11 TOWNSHIP 5 RANGE 27W

WELL NO. #1 Koerterich "B"

COMPANY R.W. Shields

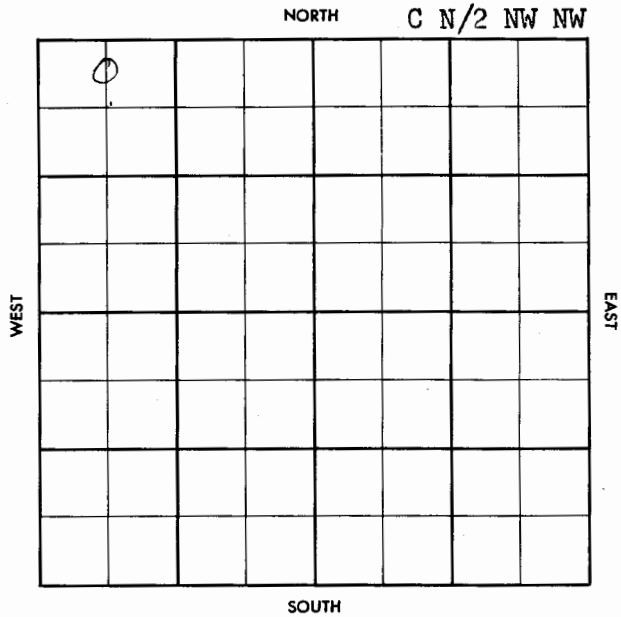

4

County Decatur Elev. 2586  
 Sec. 11 Twp. 5 Rge. 27W  
 Company R. W. Shields No. 1  
 Farm Name Koerterich "B"

TOPS	DEPTH	LOG	DATUM	Loc. in Sec.
Ans.				C N/2 NW NW
Tr.	3529			
Dg.				Geol. <u>R. Welty</u>
Bl.	3572			
L.				Contr. <u>Barnett Drlg</u>
K.C.				
B.K.C.				Pool <u>Feely</u>
Ce.				
C.				<div style="border: 1px solid black; padding: 5px; text-align: center;">           ABANDONED            APR 24 '57         </div>
M.				
K.				
Mz.				
Ma.				
V.				
S.				
S.				
A.				
R.				
PE.				
G.				

Date Comm. 4-15-57  
8" @ 245/175, WOC  
-3616 134 ma rec 55' VSO CM  
BHP 103  
DEA

County Decatur Elev. \_\_\_\_\_  
 Sec. 11 Twp. 5 Rge. 27W  
 Company R. W. Shields  
 Farm Name Koerterich "B" No. 1

TOPS	DEPTH	LOG	DATUM	Loc. in Sec.
Ans.				C N/2 NW NW
Tr.				
H.				Geol. <u>R. Welty</u>
Tr.				
Dg.				Contr. <u>Barnett Drlg</u>
Bl.				
L.				Pool <u>Feely</u>
K.C.				
B.K.C.				<div style="border: 1px solid black; padding: 5px; text-align: center;">           APR 17 '57         </div>
Ce.				
C.				FIRST REPORT
M.				
K.				
Mz.				
Ma.				
V.				
S.				
S.				
A.				
R.				
PE.				
G.				

Date Comm. 4-15-57  
8" @ 245/175, WOC

33