


Section 11 Township 5 Range 27W
Well No. #1 Feely "B"
Company R.W. Shields

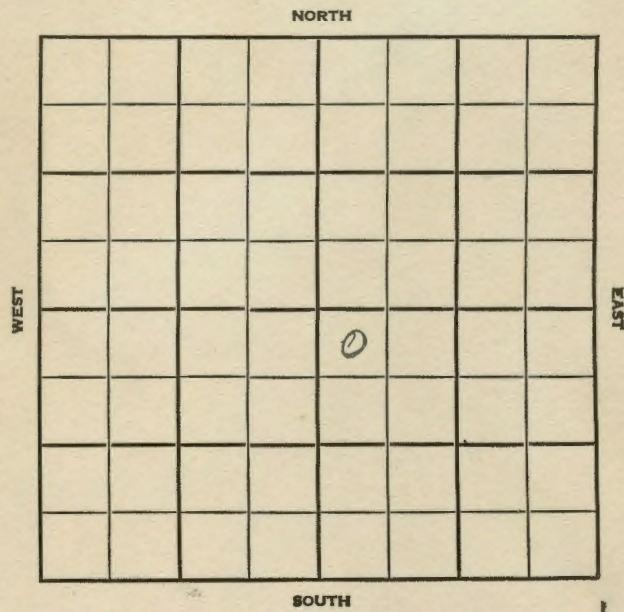

10

County Decatur Elev. 2657
 Sec. 11 Twp. 5 Rge. 27W
 Company R. W. Shields
 Farm Name Feely "B" No. 1

TOPS	DEPTH	LOG	DATUM	Loc. in Sec.
Anh.	2221			NW NW SE
Tr.				
H.				
Tr.				
Dg.				
Bl.				
L.	3644			Geol.
K.C.				Contr.
B.K.C.				Barnett Tool
Ce.				Pool
C.				Feely
M.				
M.				
K.				
Mz.				
Me.				
V.				
S.				
S.				
A.				
R.				
Pe.				
G.				
TD.				

Loc. in Sec. NW NW SE
 Geol.
 Contr. Barnett Tool
 Pool Feely

NOV 21 '56

FIRST REPORT

Date Comm. spd. 11-13-56
8" @ 213 w/175, DST 3363-78-60, R 20' M,
BHP 540/nt, DST 3675-93-60, BHP O#

33

County Decatur Elev. 2657
 Sec. 11 Twp. 5 Rge. 27W
 Company R. W. Shields
 Farm Name Feely "B" No. 1

TOPS	DEPTH	LOG	DATUM	Loc. in Sec.
Anh.	2221			NW NW SE
Tr.				
H.	3604			
Tr.				
Dg.				
Bl.				
L.	3644			Geol.
K.C.				Contr.
B.K.C.				Barnett Tool
Ce.				Pool
C.				Feely
M.				
M.				
K.				
Mz.				
Me.				
V.				
S.				
S.				
A.				
R.				
Pe.				
G.				
TD.	3693			

Loc. in Sec. NW NW SE
 Geol.
 Contr. Barnett Tool
 Pool Feely

ABANDONED

DEC 5 '56

Date Comm. spd. 11-13-56
8" @ 213 w/175, DST 3663-78-60, R 20' M,
BHP 540/nt, DST 3675-93-60, BHP O#
1 hr. sec 7' Md. DEC 5 '56

DEC 5 '56