


Section 11 Township 5 Range 27W

Well No. 1 Randall

Company Sterling Drlg.

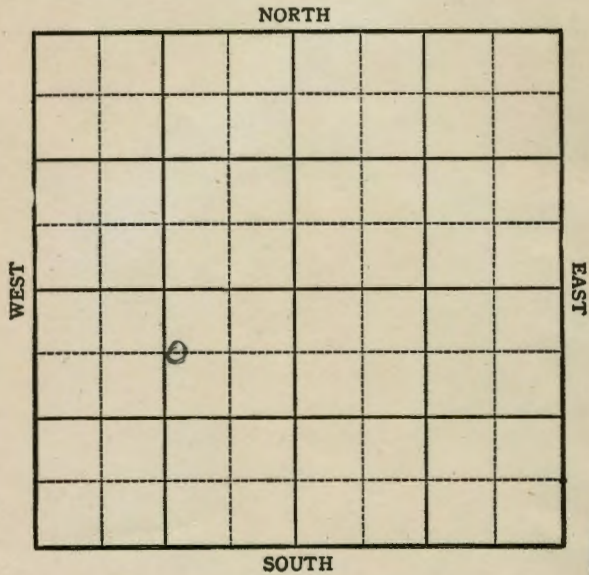

11

Sec. 11 Twp. 5 R. 27W

Well No. #1 Randall Farm _____


Sterling Drlg Company _____

660 Ft. from N. Line

_____ Ft. from S. Line

990 Ft. from E. Line

_____ Ft. from W. Line

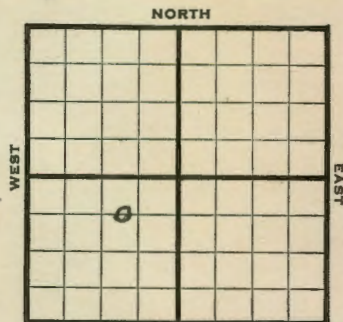

Elev. 2636

SOUTH
C W L N E SW

1944

REPORT

8/30 Pitg
 9/8 RUR
 9/13 10" @ 265' Drlg. 1345
 9/21 **Anhy 2045**
 Drlg. 2785
 9/28 **Heebner 3586**
Lans 3611
 Drlg. 3745
 10/4 **Arb 4044**
Granite 4132
 TD 4144

ABANDONED

Pool Name Wildcat

Map No. 135 Sec. 11 Twp. 5 R. 27W

Well No. 1 Randall

Sterling Drlg. Company

ABANDONED Contractor

C W L NE SW

SECTION PLAT

	o		

660 Ft. from N. Line

_____ Ft. from S. Line

990 Ft. from E. Line

_____ Ft. from W. Line

Decatur County

Location _____

Rig up _____

Drilling and Remarks:

*See 4044
Granite 482*

RECORD

Cased _____ in., _____ ft.

Sand _____

Gas _____

Oil _____

Total Depth 4146

PRODUCTION

1st 24 hrs. Nat. _____

1st 24 hrs. after shot _____

Gas _____ Cu. Ft.

Dry Hole _____

Abandoned _____

Date

OCT 4 1944

S. J. LEWIS Scout

Pool Name wildcat

Map No. KANSAS Sec. 11 Twp. 5 R. 27W

Well No. 1 Randall

Sterling Drlg. Company

FIRST REPORT Contractor

C W L NE SW

SECTION PLAT

	o		

660 Ft. from N. Line

_____ Ft. from S. Line

990 Ft. from E. Line

_____ Ft. from W. Line

Decatur County

Location _____

Rig up _____

Drilling and Remarks:

Pits

RECORD

Cased _____ in., _____ ft.

Sand _____

Gas _____

Oil _____

Total Depth _____

PRODUCTION

1st 24 hrs. Nat. _____

1st 24 hrs. after shot _____

Gas _____ Cu. Ft.

Dry Hole _____

Abandoned _____

Date

AUG 30 1944

S. J. LEWIS Scout