


Decatur **KANSAS**

Section 14 Township 5 Range 27 W

Well No. # 1 Maher-Feeley

Company R. W. Shields

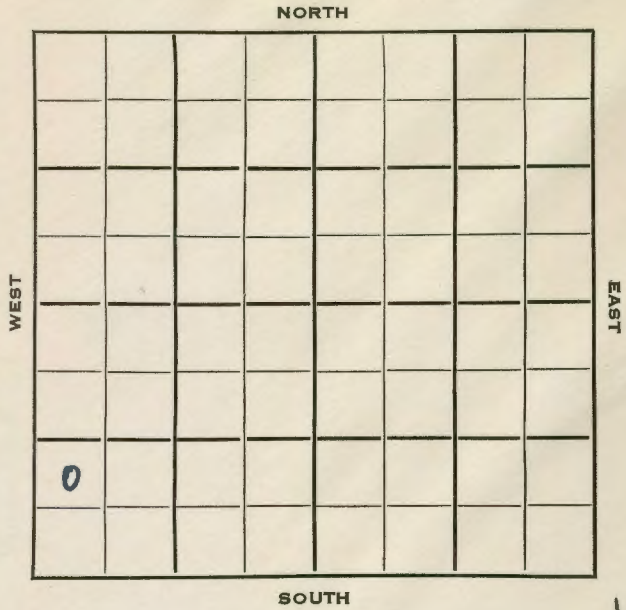

13

Decatur

SEC. 14 TWP. 5 R. KANSAS 27W ✓

WELL NO. #1 Maher-Feeley FARM

COMPANY R.W. Shields

CONTRACTOR Barnett Drlg. Hardesty Pool


_____ Ft. from N. Line

990 _____ Ft. from S. Line

_____ Ft. from E. Line

330 _____ Ft. from W. Line

NW SW SW

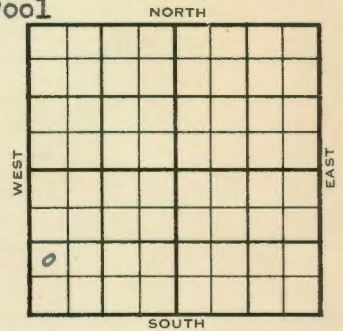

1953 ^{2671' LN} **2673' RB** REPORT

11/18 Spud 11-12-53
8" @ 212'
Anhy 2250', Ft. Riley 2720'
Drlg 2720'

12/9 Spud 11-12-53
D & A TD 3915' 8" @ 212
Anhy 2250 Ft. Riley 2720'
Heeb 3647' Lans 3690'
DST 3681-3709 open 1 hr rec 390' SW
1000# B KC 3880' TD 3915
Schl tops: **Heeb 3648' Lans 3688**
Marm. 3880' TD 3915' D & A

ABANDONED

