


Decatur

Section 14 Township 5 Range 27W

Well No. #2 Maher-Feely

Company R. W. Shields

NORTH

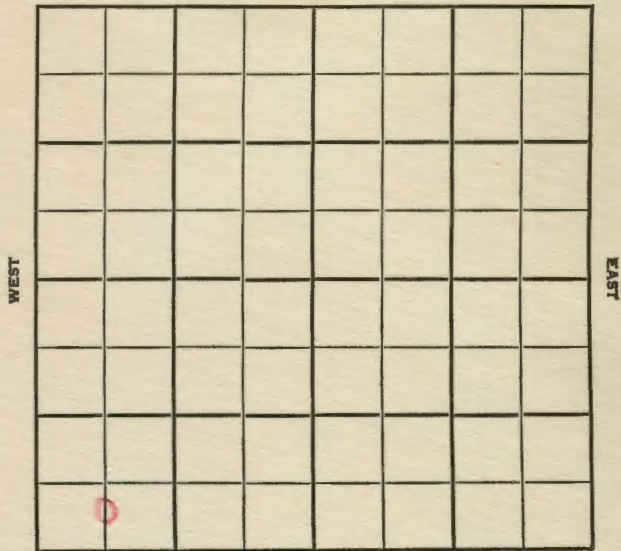

SOUTH

13

Decatur

KANSAS


SEC. 14 TWP. 5 R. 27W

WELL NO. 2 Maher-Feely FARM

COMPANY Barnett

CONTRACTOR Hardesty

NORTH

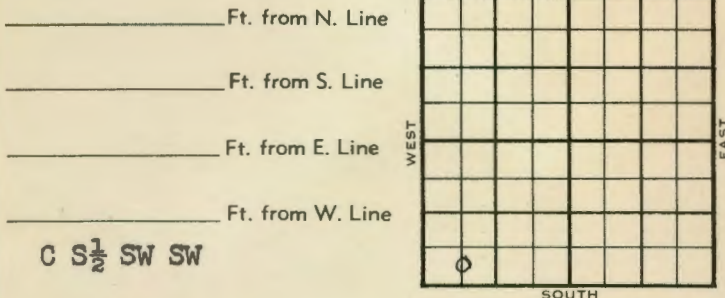

C S $\frac{1}{2}$ SW SW

ELEVATION REPORT

1955 2672'

6/22 Comm 6-16-55
8" @ 207/125
Drlg 3330

7/277 DST 3671-3700 open 45 min, Rec. 220'
clean oil 200# DST 3705-30 open 1 hr.
Rec. 30' ocm 270# 5 $\frac{1}{2}$ " @3768 CO to 3750
32/3793-11, S/3 $\frac{1}{4}$ boph 500A S/4 boph
SP 3700 16/3694-98 S/1 boph 500A S/
6 boph CO to 3750 S/10-11 boph Comp.
281 bopd.

Anh. 2249
H. 3628 956
L. 3667 995
TD. 3770

COMPLETED

County Decatur Elev. _____
 Sec. 14 Twp. 5 Rge. 27W
 Company R. W. Shields
 Farm Name Mahe-Feely No. 2

TOPS	DEPTH	LOG	DATUM	Loc. in Sec.
Anh.	2240			C S $\frac{1}{2}$ SW SW
Tr.				
H.				
Tr.				
Dg.				
Bl.				
L.				Geol. _____
K.C.				Contr. _____
B.K.C.				
Ce.				<u>Barnett</u>
C.				
M.				Pool _____
M.				<u>Hardesty</u>
K.				
Mz.				
Me.				
V.				
S.				
S.				
A.				
R.				
PE.				
G.				
TD.				

Date Comm. 6-16-55
8" @ 207/125 drlg. 3330

Handwritten: 3330

Stamp: FIRST REPORT JUN 22 1955

County Decatur Elev. 2672
 Sec. 14 Twp. 5 Rge. 27W
 Company R. W. Shields
 Farm Name Mahe-Feely No. 2

TOPS	DEPTH	LOG	DATUM	Loc. in Sec.
Anh.	2240			C S $\frac{1}{2}$ SWSW
Tr.				
H.	3628		956	
Tr.				
Dg.				
Bl.				
L.	3667		995	Geol. _____
K.C.				Contr. _____
B.K.C.				
Ce.				<u>Barnett</u>
C.				
M.				Pool _____
M.				<u>Hardesty</u>
K.				
Mz.				
Me.				
V.				
S.				
S.				
A.				
R.				
PE.				
G.				
TD.	3770			

Date Comm. 6-16-55
8" @ 207/125 DST 3671-3700 open 45 min

Rec. 220' clean oil 200# DST 3705-30
 open 1 hr. Rec. 30' ocm 270#
5 1/2" @ 3768 CO to 3750 32/ 3703-11
 S/ 3/4 boph 500 A S/ 4 boph SP 3700
 16/ 3694-98 S/ 1 boph 500 A
 S/ 6 boph CO to 3750 S/ 10-11 boph
 Comp. 281 bopd

Stamp: COMPLETE