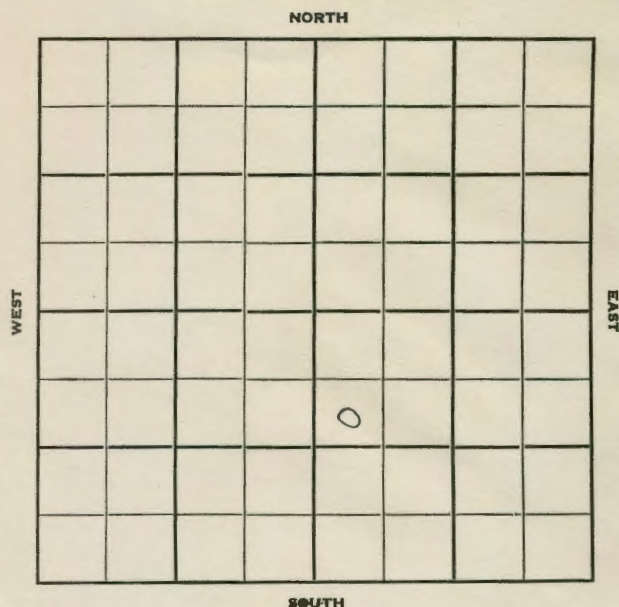


KANSAS

Section 14 Township 5 Range 27WWell No. #1 McLaughlinCompany Empire Drlg.

10

Decatur

KANSAS

Sec. 14 Twp. 5 R. 27WWell No. #1 McLaughlin FarmEmpire Drlg. CompanyEmpire Drlg. - Contr. Contractor

Hardesty Pool


990' Ft. from N. Line

Ft. from S. Line

Ft. from E. Line

330' Ft. from W. Line

SW NW SE

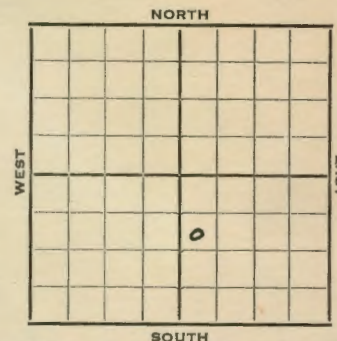

1952 Elev. 2664' REPORT

3/19 MIR

4/2 Spud 3-20-52
D&A TD 4165
8" @ 252

Anhy 2255 Top. 3488

Heeb. 3651 Dodge 3671

Lans. 3688


DST 3716-32 opn 45 min. Rec. 25'mud

ReArb. 4112 Arb. 4129 TD 4165

D&A

ABANDONED

County **Decatur** State **Kansas**
 Sec. **14** (Bk. **5** (Sur. **27W** Map No.
 Operator **Empire Drlg.**
 Well No. **1** Farm **McLaughlin**
 Elev. Location **SW NW SE**

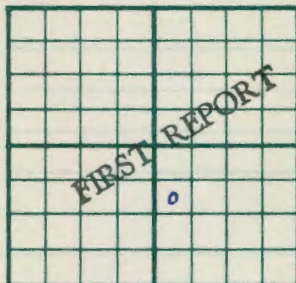


990 Ft. From **N** Line **SE**
330 Ft. From **W** Line Quarter
 1st. Report **MAR 19 1952**
 Completion
 Remarks **Empire Drlg. - Contr.**
 Spudding Date

Drlg. Data

Hardesty Pool**M I R**

J. G. McGEHEE

County **Decatur** State **Kansas**
 Sec. **14** (Bk. **5** (Sur. **27W** Map No.
 Operator **Empire Drlg.**
 Well No. **1** Farm **McLaughlin**
 Elev. **2664** Location **SW NW SE**

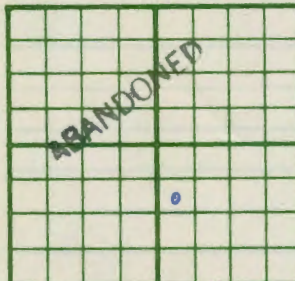

990 Ft. From **N** Line **SE**
330 Ft. From **W** Line Quarter
 1st. Report
 Completion **APR 2 1952**
 Remarks **Hardesty Pool**
Empire Drlg. - Contr.
 Spudding Date **3-20-52**

Drlg. Data **D & A** **TD 4165****8" @ 252 Anhy 2255 Top. 3488****Heeb. 3651 Dodge 3671 Lans. 3688****DST 3716-32 open 45 min. Rec. 25' mud****ReArb. 4112 Arb. 4129 TD 4165****D & A**

J. G. McGEHEE