


Section 15 Township 5 Range 27 W

Well No. # 1 Feely

Company R. W. Shields

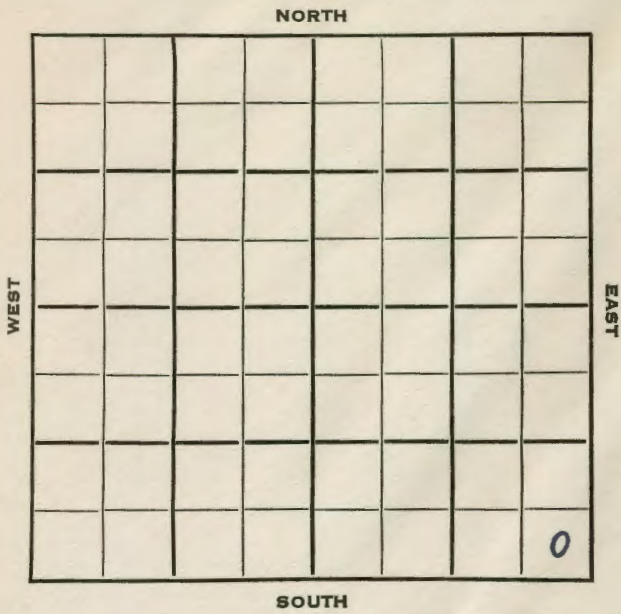


16

SEC. 15 TWP. 5 R. 27W

WELL NO. #1 Feely FARM

COMPANY R.W. Shields

CONTRACTOR Barnett Drlg. Hardesty Pool

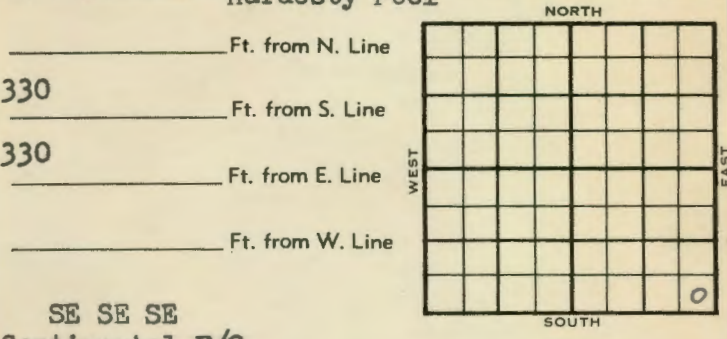

_____ Ft. from N. Line
 330 _____ Ft. from S. Line
 330 _____ Ft. from E. Line
 _____ Ft. from W. Line

SE SE SE Continental F/O

1953	ELEVATION	REPORT
	2675'	

10/21 Spud 10-17-53
Drlg 900'

10/28 8" @ 222 Heeb 3632' Lans 3673'
DST 3663-85, 20 mins, 5' M
Drlg. 3686'

11/4 B KC ~~368~~ 3866' TD 3900'
5" @ 3896 36/3721-68 HFW
D & A
"

11/11
11/18
11/24 Spud 10-17-53
D & A
TD 3900'
8" @ 222'
Heeb 3632, Lans 3673,
DST 3663'-85' opn 20 min, rec 5' Mud
B KC 3866'
TD 3900'
5" @ 3896'
Schlumberger Tops: Heeb 3634, Lans
3674, B KC 3866'
TD 3899'
24/ 3761-68 B/ 2 1/2 bwph PB 3766
14/ 3746-51 B/ 1 1/2 bwph 8/ 3751-55
S/ 14 bwph SSO PB 3738 4/ 3716-18
B/ 1 1/2 bwph PB 3710 15/ 2703-08

OVER

1953

Information brought forward.

11/24

B/ 1 gwph 500 A S/ 1 bfph
18/ 3698-3704 2000 A S/ 1½ bfph
PB 3693 36/ 3673-85 S/ 1 bwph
1500 A S/ 3 bwph
TD 3900'
D & A

ABANDONED

County Decatur State Kansas
 Sec. 15 (Blk. 5 (Sur. 27W (Twp. 5) Map No.
 Operator R. W. Shields
 Well No. 1 Farm Feely
 Elev. _____ Location SE SE SE

330 Ft. From S Line SE
330 Ft. From E Line Quarter
 Ist. Report OCT 21 1953
 Completion _____
 Remarks Continental farmout
Barnett Drlg. - Contr.
 Spudding Date 10-17-53

Drlg. Data Hardesty Pool
drlg. 900

J. G. McGEHEE

County Decatur State Kansas
 Sec. 15 (Blk. 5 (Sur. 27W (Twp. 5) Map No.
 Operator R. W. Shields
 Well No. 1 Farm Feely
 Elev. 2675 Location SE SE SE

330 Ft. From S Line SE
330 Ft. From E Line Quarter
 Ist. Report _____
 Completion NOV 24 1953
 Remarks Hardesty Pool
Barnett Drlg. - Contr.
 Spudding Date 10-17-53

Drlg. Data D & A TD 3900
8" @ 222 Heeb. 3632 Lans. 3673
DST 3663-85 open 20 min. Rec. 5' mud
B KC 3866 TD 3900 5" @ 3896
SCHLUMBERGER TOPS
Heeb. 3634 Lans. 3674 B KC 3866
TD 3899 24/ 3761-68 B/ 2½ bwph
PB 3766 14/ 3746-51 B/ 1½ bwph
8/ 3751-56 S/ 14 bwph SSO PB 3738
4/ 3716-18 B/ 1½ bwph PB 3710
15/ 2703-08 B/ 1 gwph 500 A S/ 1 bfph
18/ 3698-3704 2000 A S/ 1½ bfph
PB 3693 36/ 3673-85 S/ 1 bwph 1500 A
S/ 3 bwph TD 3900

D & A

J. G. McGEHEE