


KANSAS

Section 15 Township 5 Range 27WWell No. #1 MuirheadCompany Harry Gore

NORTH

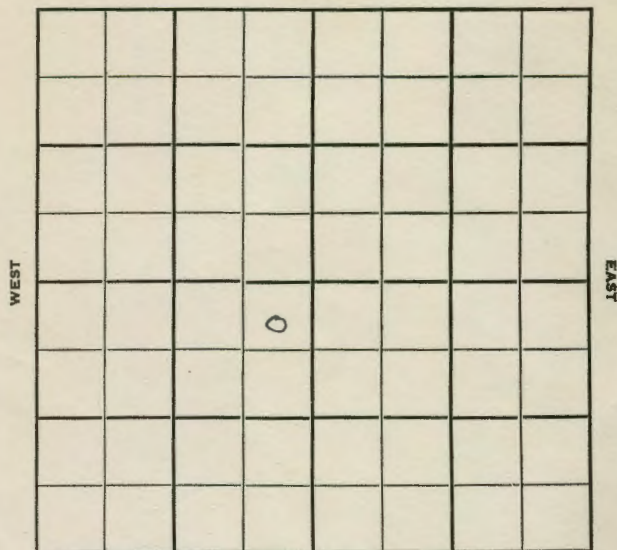

SOUTH

11

Decatur

KANSAS


Sec. 15 Twp. 5 R. 27W ✓Well No. #1 Muirhead FarHarry Gore CompaStrain Contract

Wildcat

330 Ft. from N. Line Ft. from S. Line330 Ft. from E. Line Ft. from W. Line

NE NESW

NORTH

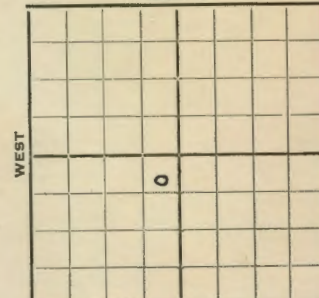

SOUTH

1952 Elev. 2699' REPORT

3/5 MI

3/12 "

3/19 "

3/25 Anhy 2325
Drlg. 3563'4/9 Spud 3-25-52
D&A TD 4160
8" @ 247

Anhy 2325

Tor. 3733

B KC 3950

TD 4160 D&A

Heeb. 3711

KC 3749


ABANDONED

County **Decatur** State **Kansas**
 Sec. **15** (Blk. **5** (Sur. **27W** Map No.

Operator **Harry Gore**

Well No. **1** Farm **Muirhead**

Elev. Location **NE NE SW**

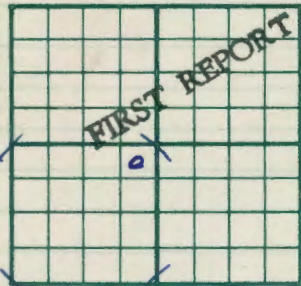

330 Ft. From **N** Line **SW**

330 Ft. From **E** Line Quarter

1st. Report **MAR 5 1952**

Completion

Remarks

Strain - Contr.

Spudding Date

Drig. Data

Wildcat

MI


J. G. McGEHEE

County **Decatur** State **Kansas**
 Sec. **15** (Blk. **5** (Sur. **27W** Map No.

Operator **Harry Gore**

Well No. **1** Farm **Muirhead**

Elev. **2699** Location **NE NE SW**

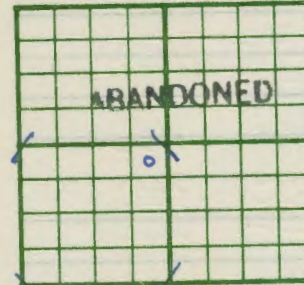

330 Ft. From **N** Line **SW**

330 Ft. From **E** Line Quarter

1st. Report

Completion **APR 9 1952**

Remarks **Wildcat**

Strain Drig. - Contr.

Spudding Date **3-25-52**

Drig. Data

D & A

TD 4160

8" @ 247 Anhy 2325 Heeb. 3711

Tor. 3733 KC 3749 B KC 3950 TD 4160

D & A

J. G. McGEHEE