


Section 22 Township 5 Range 27W

Well No. #1 Hardesty

Company Continental Oil

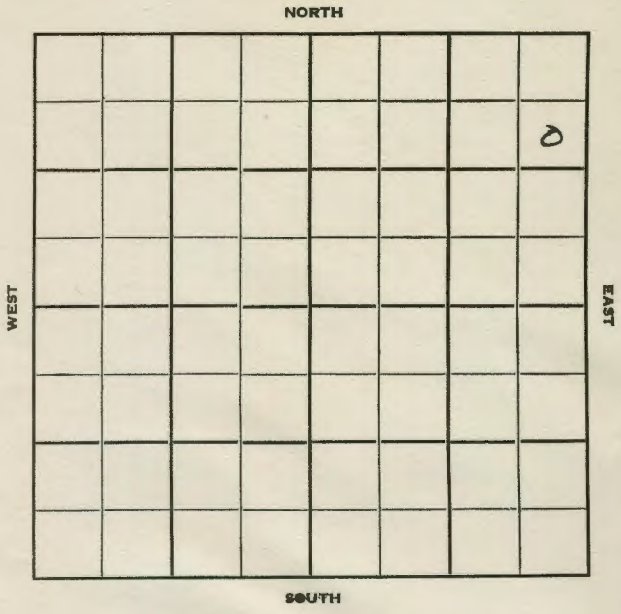

10M 10-50 PETROL **KANSAS**  
 Sec. 22 Twp. 5 R. 27W

Well No. #1 Hardesty Farm

Continental Oil Company

Lohman & Johnson Contractor

**Wildcat**


990 Ft. from N. Line

\_\_\_\_\_ Ft. from S. Line

330 Ft. from E. Line

\_\_\_\_\_ Ft. from W. Line

SE NE NE

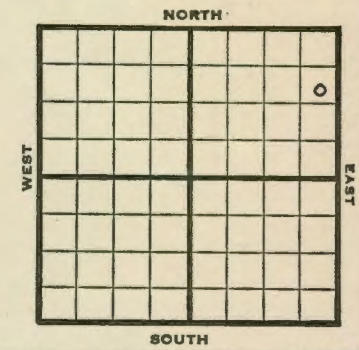

1952 **Elev. 2648'** REPORT

1/2 Spud 12-23-51  
 10" @ 269'  
 Drlg. 3124'

2/5 Spud 12-23-51  
 Oil Well TD 4095  
 10" @ 269 **Heeb. 3605 Tor. 3629**  
**Lans. 3643**  
 DST 3644-52 open 1/2 hr. rec. 110'  
 hocr DST 3672-84 open 1 hr. rec.  
 2190' oil **B KC 3892 Arb. 4054**  
 TD 4095' 5" @ 3850 CO to 3827  
 32/ 3806-14 S/ tr. oil 48/ 3788-97  
 no inc. 500 A S/ 6 BFPH 90% wtr.  
 SP 3780 sq. off 48/ 3746-58 S/ 1  
 BW tr. oil ph 80/ 3718-38 S/ 5  
 BWPB SP 3808 Sq. off DC to  
 3713 24/ 3706-12 B 1/5 BWPB & SSO  
 56/ 3678-92 S/ 8 BO 2 BWPB 24/ 3688-  
 74 S/ 17 BO 2 BWPB 15 hr. PB 3662  
 64/ 3642-58 S/ 1/2 BOPB 12 hr.  
 500 A S/ 38 BOPB 10 hr. DP 3713  
 S/ 50 bo 10 1/2 bwph 12 hr.  
 Comp. 844 BOPD 210 BW

**COMPLETED**

County Decatur State Kansas  
 Sec. 22 (Blk. 5 (Sur. 27W Map No. 5)  
 (Twp.) (Rge.)

Operator Continental Oil  
 Well No. 1 Farm Hardesty

Elev. 2648 Location SE NE NE

990 Ft. From N Line NE  
 330 Ft. From E Line Quarter

Ist. Report \_\_\_\_\_

Completion FEB 6 1952

Remarks Wildcat

Lohman & Johnson - Contr.

Spudding Date 12-23-51

Drig. Data Oil well TD 4095

10" @ 269 Heeb. 3605 Tor. 3629

Lans. 3643 DST 3644-52 open 1/2 hr.

Rec. 110' hocm DST 3672-84 open 1 hr.

Rec. 2190' oil B KC 3892 Arb. 4054

TD 4095 5" @ 3850 CO to 3827 32/ 3806-

14 S/ tr. oil 48/ 3788-97 no inc.

500 A S/ 6 bwph 90% water SP 3780

sq. off 48/ 3746-58 S/ 1 bw tr. oil ph

80/ 3718-38 S/ 5 bwph SP 3708 sq. off

DC to 3713 24/ 3706-12 B/ 1/5 bwph & SSO

56/ 3678-92 S/ 8 bo 2 bwph 24/ 3668-74

S/ 17 bo 2 bwph 15 hr. PB 3662

64/ 3642-58 S/ 1/2 bwph 12 hr. 500 A

J. G. McGEHEE

COMPLETE

County Decatur State Kansas  
 Sec. 22 (Blk. 5 (Sur. 27W Map No. 5)  
 (Twp.) (Rge.)

Operator Continental Oil  
 Well No. 1 Farm Hardesty

Elev. 2648 Location SE NE NE

990 Ft. From N Line NE  
 330 Ft. From E Line Quarter

Ist. Report JAN 2 1952

Completion \_\_\_\_\_

Remarks \_\_\_\_\_

Lohman & Johnson - Contr.

Spudding Date 12-23-51

Drig. Data Wildcat

10" @ 269 drig. 3124

FIRST REPORT

J. E. TYRA

T. C. WOODHULL

Dirg. Data

S/ 38 boph 10 hr. DP 3713 S/ 50 bo 10 1/2

bwph 12 hr.

Comp. 844 bopd 210 bw

FEB 13 1952

.....	MISC.
.....	Price Map
.....	Traces Map
.....	Traces
.....	Land with Map
.....	Land with Map
.....	Scout Cards

*ms*