


Decatur **KANSAS**

Section 22 Township 5 Range 27W

Well No. #1 Welter

Company H. Gore

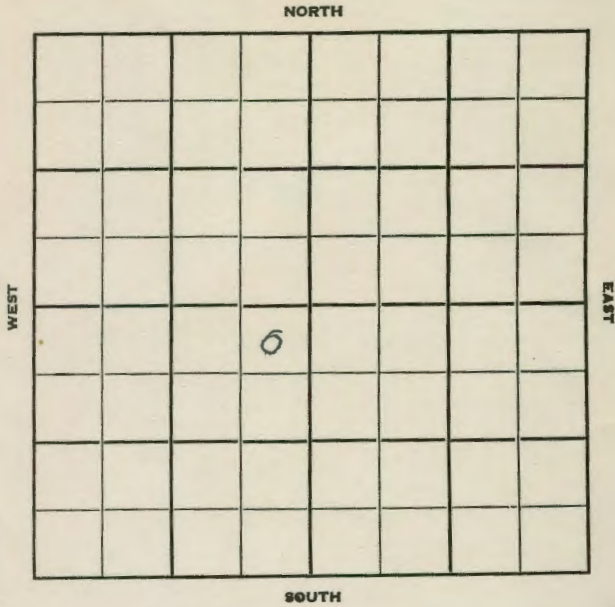

KANSAS

Decatur

Sec. 22 Twp. 5 R. 27W

Well No. #1 Welter Fat

H. Gore Compat

Empire - Contr. Contract

Wildcat


330' Ft. from N. Line

_____ Ft. from S. Line

330' Ft. from E. Line

_____ Ft. from W. Line

NE NE SW

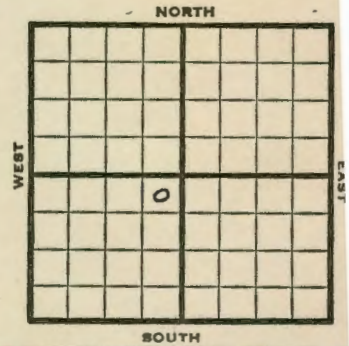

1952

Elev. 2680'

REPORT

1/23

Location

2/6

8" @ 251 **Anhy 1875 Topeka 3590**
Heeb. 3737 Brk Li 3758

DST 3765-90, 1 hr. 6' mud

Lans. 3775

DST 3804-20 1 hr. 15' salty mud

B KC 3990

Drlg. 4050'

2/13

Spud 1-23-52

D&A TD 4313'

8" @ 251'

Anhy 1875 Top. 3590 Heeb. 3737

Br Li 3758

DST 3765-90 open 1 hr. rec. 6' mud

Lans. 3775

DST 3804-20 open 1 hr. rec. 15'
salty mud

B KC 3990 TD 4313 Arb. 4277

Cong. 4223

D&A

ABANDONED

County **Decatur** State **Kansas**
 Sec. **22** (Blk. **5**) (Sur. **27W**) Map No.
 Operator **H. Gore**
 Well No. **1** Farm **Welter**
 Elev. Location **NE NE SW**

FIRST REPORT

330 Ft. From **N** Line **SW**
330 Ft. From **E** Line Quarter
 Ist. Report **JAN 23 1952**
 Completion
 Remarks **Empire - Contr.**
 Spudding Date

Drig. Data **Wildcat**
 Location

J. E. TYRA

County **Decatur** State **Kansas**
 Sec. **22** (Blk. **5**) (Sur. **27W**) Map No.
 Operator **H. Gore**
 Well No. **1** Farm **Welter**
 Elev. **2680** Location **NE NE SW**

ABANDONED

330 Ft. From **N** Line **SW**
330 Ft. From **E** Line Quarte
 Ist. Report
 Completion **FEB 13 1952**
 Remarks **Wildcat**
Empire - Contr.
 Spudding Date **1-23-52**

Drig. Data **D & A** **TD 4313**
8" @ 251 Anhy **1875** Top. **3590**
Heeb. 3737 Br. lime **3758** DST **3765-90**
open 1 hr. Rec. **6'** mud **Lans. 3775**
DST 3804-20 open **1 hr.** Rec. **15'** salty
mud B KC 3990 **TD 4313** **Arb. 4277**
Cong. 4223

D & A

J. G. McGEHEE