

Decatur KANSAS

SEC. 23 TWP. 5 R. 27 W

WELL NO. # 1 Cora Comfort FARM

COMPANY R. W. Shields

CONTRACTOR Barnett


330 Hardesty Pool Ft. from N. Line

Ft. from S. Line

Ft. from E. Line

660 Ft. from W. Line

C N 1/2 NW SW

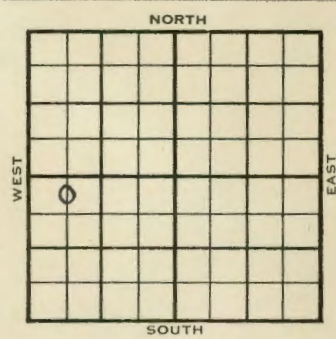

ELEVATION	REPORT
1954	2642'

10/27 Location

11/23 Spud 11-3-54
 D & A
 TD 3865'
 8-5/8" @ 214'
Anhy 2230', Heeb 3614', Lans 3653'
 DST 3642'-57' op 20 min, rec 210' Mud
 350#
 DST 3687'-3726' opn 1 hr, rec 35' vsocm
 510# **B KC 3856'**
 TD 3865'
 D & A

ABANDONED


DX 78-1

Decatur KANSAS

Section 23 Township 5 Range 27W

Well No. 1 Cora Comfort

Company R. W. Shields

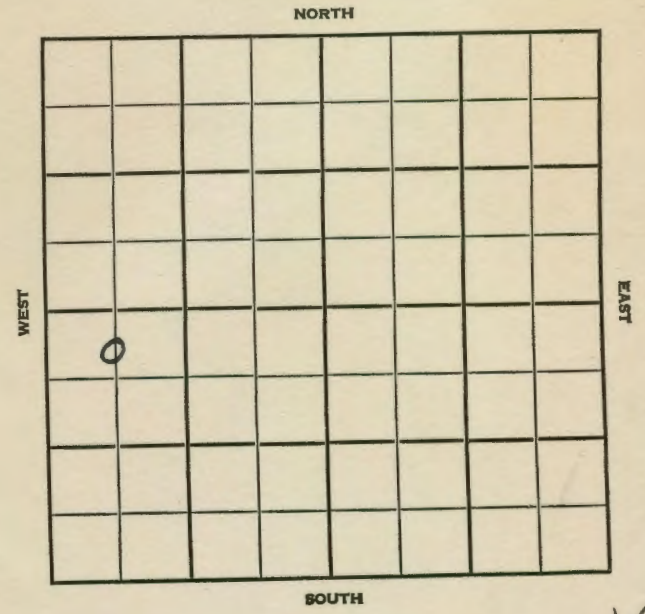

12

