


Section 25 Township 5 Range 27W

Well No. #1 Noone

Company Barnett Drlg.

NORTH

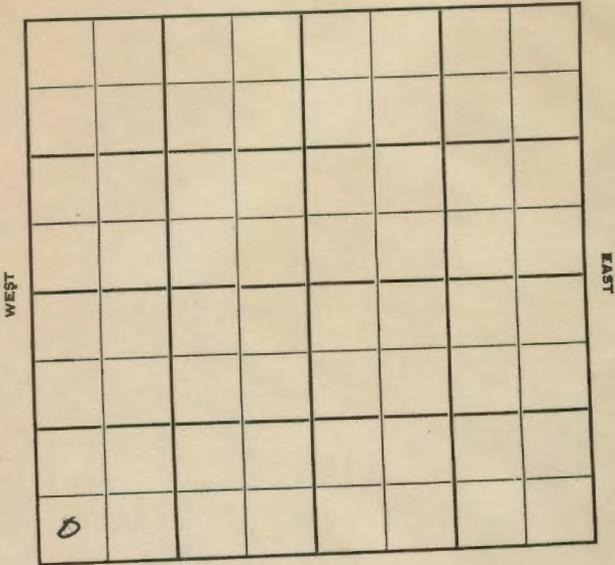

SOUTH

13

Sec. 25 Twp. 5 R. 27W

Well No. #1 Noone Farm

Barnett Drlg. Company

Wildcat Contractor

Ft. from N. Line

330

Ft. from S. Line


Ft. from E. Line

330

Ft. from W. Line

SW SW SW

NORTH

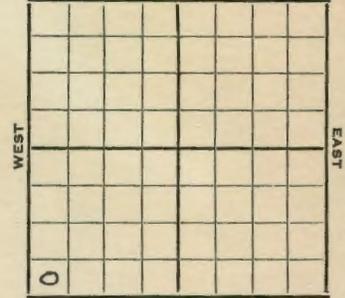

SOUTH

1952

Elev. 2622'

REPORT

5/7

8" @ 267' WOC  
Spud 5-4-52

5/14

Anhy 2265' Topeka 3672' Lans. 3691'  
Drlg. 3900'

5/21

Spud 5-4-52  
D&A TD 4225' 8" @ 267'  
Anhy 2265' Top. 3672  
Lans. 3691' Arb. 4181  
TD 4225' D&A

ABANDONED

