


Decatur

Section 26 Township 5 Range 27-W
 Well No. #1 Feely
 Company Derby Oil et al

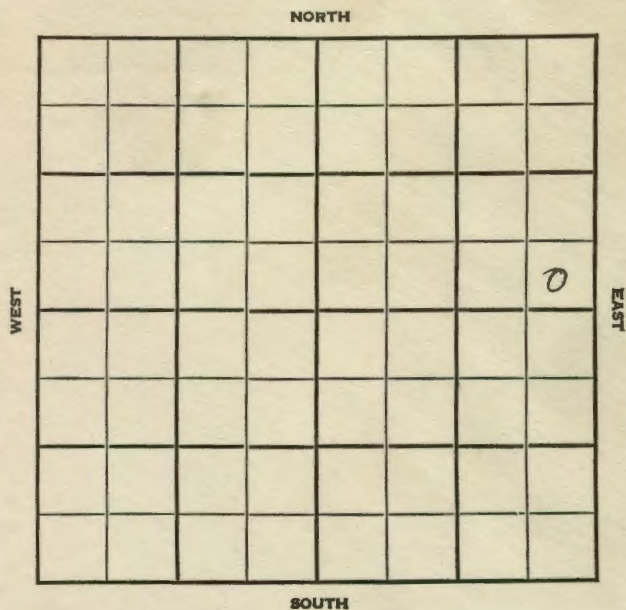

8

KANSAS

Decatur

Sec. 26 Twp. 5 R. 27W
 Well No. #1 Feely Farm
Derby Oil et al Company
Wildcat


Ft. from N. Line

330' Ft. from S. Line

330' Ft. from E. Line

Ft. from W. Line

SE NE

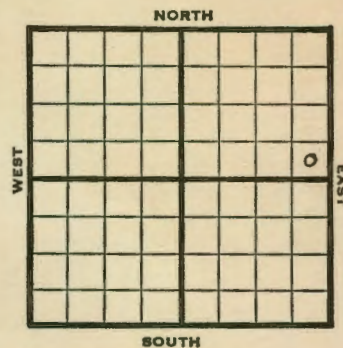

1948

Eli 2625'

REPORT

6/23

Location

6/29

8" @ 247'
Drlg. 2725'

7/8

Lansing 3609'
Arbuckle 4076'
TD 4080'
5" @ 4077'
RUST

7/14

"

7/21

Arbuckle 4113'
TD 4119'

7/28

Arb. 4113'
5" @ 4077'
TD 4119'
Aband.

ABANDONED

Map No. _____ Sec. 26 Twp. 5 R. 27WWell No. 1 Feely

Derby Oil etal. _____ Company

FIRST REPORT _____ Contractor

SE NE

SECTION PLAT

_____ Ft. from N. Line

330 _____ Ft. from S. Line330 _____ Ft. from E. Line

_____ Ft. from W. Line

Decatur County

Location X

Rig up _____

Drilling and Remarks:

RECORD

Cased 4 in., _____ ft.

Sand _____

Gas _____

Oil _____

Total Depth _____

PRODUCTION

1st 24 hrs. Nat. _____

1st 24 hrs. after shot _____

Gas _____ Cu. Ft.

Dry Hole _____

Abandoned _____

Date

JUN 23 1948 19 S. J. LEWIS Scout

Decatur _____ County _____ Kansas _____ State

Map No. 135 Sec. 26 Twp. 5 R. 27WWell No. 1 Feely

Derby Oil etal. _____ Company

ABANDONED

Contractor

SE NE

SECTION PLAT

_____ Ft. from N. Line

330 _____ Ft. from S. Line330 _____ Ft. from E. Line

_____ Ft. from W. Line

Wildcat

Remarks:

Q 41135' 0 407770 4119Date
JUL 28 1948Scout
S. J. LEWIS