


Section 23 Township 5 Range 27W

Well No. #3 Danley Est.

Company Shields

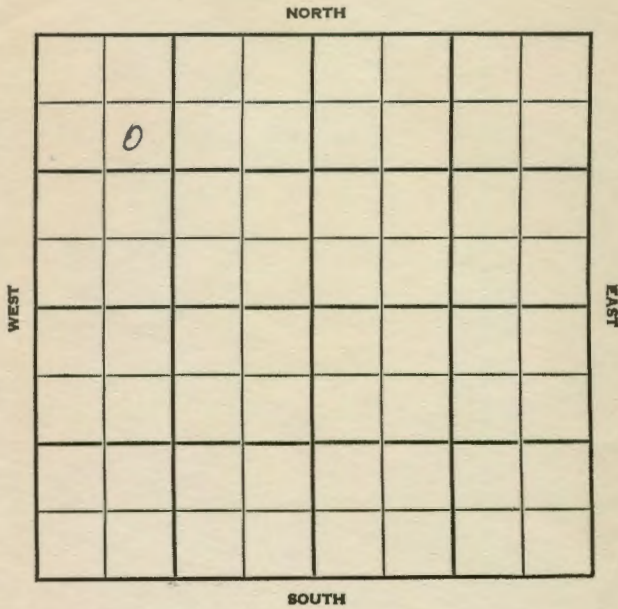

SEC.	TWP.	R.
23	5	27W ✓

WELL NO. 3 Danley Est. FARM

COMPANY Shields


CONTRACTOR Barnett & Shields

990 Ft. from N. Line

_____ Ft. from S. Line

_____ Ft. from E. Line

990 Ft. from W. Line

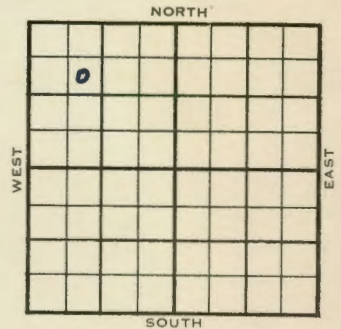

SE NW NW

1954	ELEVATION	REPORT
	2662'	

4/27 MIR
 5/5 8" @ 219 w/150
 5/12 Drlg. 3614'
 Lans. 3657'
 DST 3643-78, 1 hr, 80' Heavily OCM
 220' gas. 345# RTD 3765'
 6/23 Spud 4-27-54
 Oil Well
 TD 3765'
 8" @ 219'
 Heeb 3615', Tor 3637', Lans 3657'
 DST 3643-78', opn 1 hr., rec. 80'
 hocrn, 220' gas, 345#
 TD 3765'
 5" @ 3764'
 CO to 3734'
 12/3692-96, 1 goph 7 hrs.
 12/3682-86, S/5 boph 300A
 S/6 boph 10 hrs.
 Comp. 125 bopd

COMPLETED

