

Sec. 23 Twp. 5 R. 27W

Well No. #1 Danley Est. Farm

R. W. Shields Company

Barnett Drlg. Contractor


330 Ft. from N. Line

Ft. from S. Line

Ft. from E. Line

330 Ft. from W. Line

NW NW NW

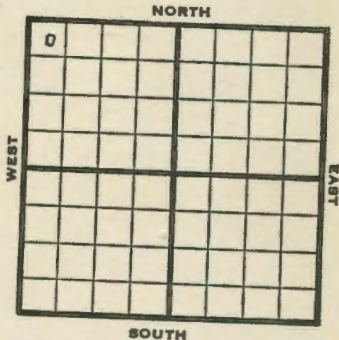

1952 Elev. 2670' REPORT


- 12/10 Spud 12/2/52
8" @ 225 Anhy 2223'
Drlg. 3103'
- 12/11 "
- 12/18 Topeka 3407 Heeb 3625 Lans 3661 DST
3662-80 40 Mins 270' Gas 210' Hly
OCM 830# Ø 3775
- 12/25 Topeka 3407 Heeb 3625 Lans. 3661 DST
3662-80 40 mins. 270' gas 210' Hly OCM
830# Drlg. 3775
- 1/1 24/3698-3704 FU 1900' Fluid 12 hrs.
s/18 BF 3 hrs. 50% Wtr.
- 1/8 12/3688-92 1 BOPH 500A 12 BOPH 4 Hrs.
FU 2100' Oil 12Hrs. PB 18/3661-66
6/3671-73 1 BOPH 5 OOA POP
- 1/15 "
- 1/22 NR
- 1/28 Spud 12-2-52
Oil Well
TD 3910
8" @ 225
Anhy 2223, Top 3407, Heeb 3625,
Lans 3661
DST 3662-80, opn 40 mins., rec.
270' gas, 210' hocm, 830#
TD 3910
5" @ 3902
36/3737-48, FU 7½ bfph 40% wtr.

OVER

Section 23 Township 5 Range 27W

Well No. 1 Danley Est.

Company R. W. Shields

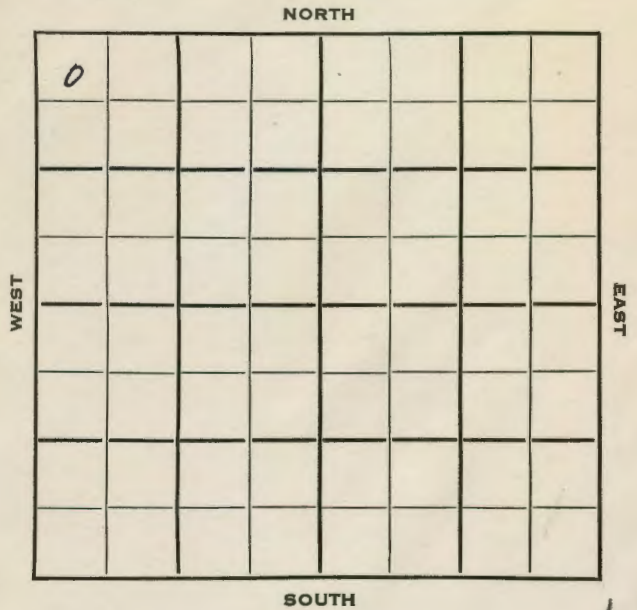

4

#1 Danley Est.
(Information Brought Forward)

1953
1/28

FU 1900' fluid 12 hrs., est
750' wtr. S/30 bf 4 hrs.
40% wtr. SP 3730, 11/3720-24,
FU 40' oil, 24/3698-3704,
FU 1900' fluid 12 hrs.
S/18 bf 3 hrs. 50% wtr.
12/3688-92, 1 boph 500A
20 boph 4 hrs.
FU 2100' oil 12 hrs. PB
12/3661-66, 6/3671-73, 1 boph
500A S/12 boph 4 hrs.
CO to 3698 S/27 boph
Comp. 515 bopd

COMPLETED

County **Decatur** State **Kansas**
 Sec. **23** (Blk. Twp.) **5** (Sur. Rge.) **27W** Map No.
 Operator **R. W. Shields**
 Well No. **1** Farm **Danley Est.**
 Elev. **2670** Location **NW NW NW**

0					

330 Ft. From **N** Line **NW**
330 Ft. From **W** Line **Quarter**
 Ist. Report
 Completion **JAN 9 1953**
 Remarks
Barnett Drlg. - Contr.
 Spudding Date **12-2-52**

Drig. Data **Oil well TD 3910**
8" @ 225 Anhy 2225 Top. 3407
Heeb. 3625 Lans. 3661 DST 3662-80
open 40 min. Rec. 270' gas 210' hoem
830# TD 3910 5" @ 3902 36/ 3737-48
FU 7½ bph 40% wtr. FU 1900' fluid
12 hr. est. 750' wtr. S/ 30 bf 4 hr.
40% wtr. SP 3730 11/ 3720-24
FU 40' oil 24/ 3698-3704 FU 1900' fluid
12 hr. S/ 18 bf 3 hr. 50% wtr.
12/ 3688-92 1 boph 500 A 20 boph 4 hr.
FU 2100' oil 12 hr. PB 12/ 3661-66
6/ 3671-73 1 boph 500 A S/ 12 boph
4 hr. CO to 3698 S/ 27 boph
Comp. 515 bopd

J. G. McGEHEE

County **Decatur** State **Kansas**
 Sec. **23** (Blk. Twp.) **5** (Sur. Rge.) **27W** Map No.
 Operator **R. W. Shields**
 Well No. **1** Farm **Danley Est.**
 Elev. Location **NW NW NW**

0					

330 Ft. From **N** Line **NW**
330 Ft. From **W** Line **Quarter**
 Ist. Report **DEC 10 1952**
 Completion
 Remarks
Barnett Drlg. - Contr.
 Spudding Date **12-2-52**

Drig. Data
8" @ 225 Anhy 2225 drlg. 3108

J. G. McGEHEE