

Decatur

KANSAS

Sec. 24 Twp. 5 R. 27W

Section 24 Township 5 Range 27W

Well No. #1 Donley est Farm

Well No. #1 Donley est.

Mid-States

Company Mid-States

Barnett

Company

Wildcat

Contractor

Ft. from N. Line

330


Ft. from S. Line

330

Ft. from E. Line

Ft. from W. Line

SE SE SW

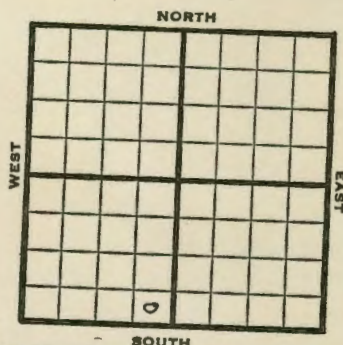

1952 Elev. 2642' REPORT

3/26 Spud 3-22-52
8" @ 279'

Drlg.

4/1 Anhy 2265 Topeka 3466

Heeb. 3683

Drlg. 3755'

4/9 Spud 3-22552

D&A TD 4230'

8" @ 279'

Anhy 2265

Top. 3466

Heeb. 3683

Lans. 3721

DST 3745-61 open 1 hr. rec. 140'


smcsw

Cong. 4136

Arb. 4195


TD 4230' D&A

ABANDONED

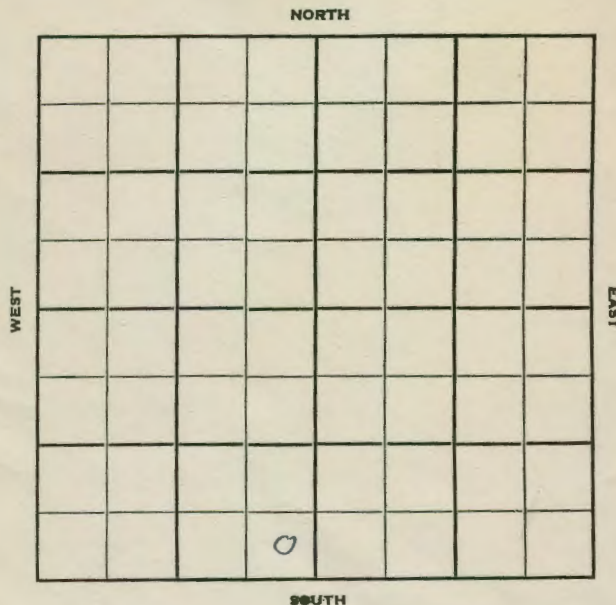

14

County Decatur State Kansas
 Sec. 24 (Blk. 5) (Sur. 27W) Map No.
 Operator Mid-States
 Well No. 1 Farm Donley Est.
 Elev. 2642 Location SE SE SW

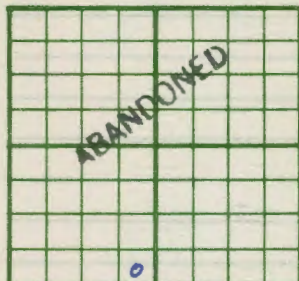

330 Ft. From S Line SW
330 Ft. From E Line Quarter
 Ist. Report
 Completion APR 9 1952
 Remarks Wildcat
Barnett - Contr.
 Spudding Date 3-22-52

Drlg. Data D & A TD 4230
8" @ 279 Athy 2265 Top. 3466
Heeb. 3683 Lans. 3721 DST 3745-61
open 1 hr. Rec. 140' smcsw Cong. 4136
Arb. 4195 TD 4230

D & A

J. G. McGEHEE

County Decatur State Kansas
 Sec. 24 (Blk. 5) (Sur. 27W) Map No.
 Operator Mid-States
 Well No. 1 Farm Donley est
 Elev. Location SE SE SW



330 Ft. From S Line SW
330 Ft. From E Line Quarte
 Ist. Report MAR 26 1952
 Completion
 Remarks
Barnett - Contr.
 Spudding Date 3-22-52

Drlg. Data Wildcat
8" @ 279 Drlg.

J. G. McGEHEE