


WELL LOG BUREAU—KANSAS GEOLOGICAL SOCIETY
508 East Murdock, Wichita, Kansas

27-5-27W

Company- LOHMAN & JOHNSON
Farm- Feely No. 1

SEC. 27 T. 5 R. 27W
NW NE NE

Total Depth. 3910
Comm. 5-31-53 Comp. 6-9-53
Shot or Treated.
Contractor.
Issued. 9-26-53

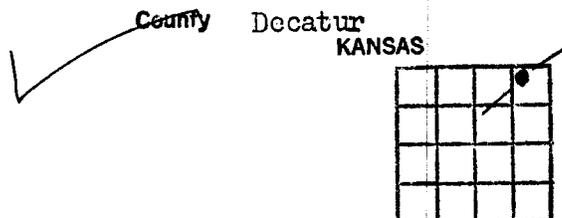

CASING:
8 5/8" 195'

Elevation. 2664

Production. Dry

Figures Indicate Bottom of Formations.

surface clay, sand	195
shale	768
shale, sand, shells	1520
shale; shells	1875
shale, red bed	2266
anhydrite	2300
shale	2700
lime, shale	3010
shale, shells	3153
shale	3240
shale, lime	3436
lime, shale	3708
lime	3773
lime, shale	3910
Total Depth	

Scout Tops:	
Anhydrite	2266
Topeka	3462
Heebner	3649
Toronto	3670
Lansing	3688
Marmaton	3888