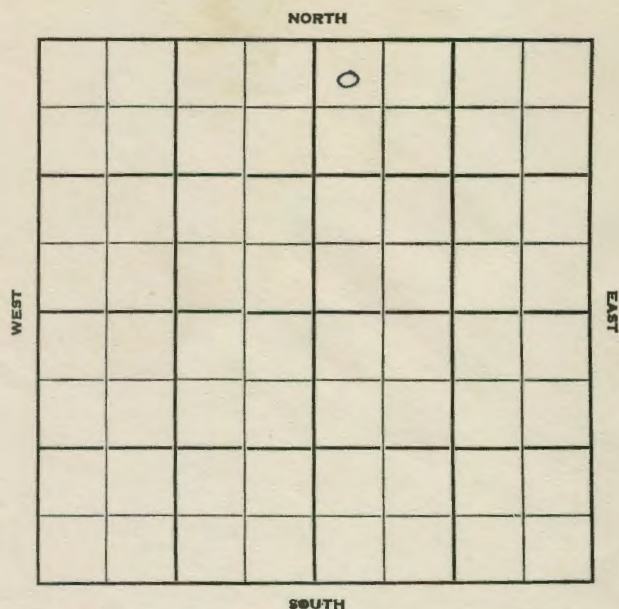


Section 26 Township 5 Range 27WWell No. #1 FeebyCompany Harry Gore

2

Sec. 26 Twp. 5 R. 27WWell No. #1 Feeby

Harry Gore

Farm

Company

Contractor

Wildcat


330' Ft. from N. Line

Ft. from S. Line

Ft. from E. Line

330' Ft. from W. Line

NW NW NE

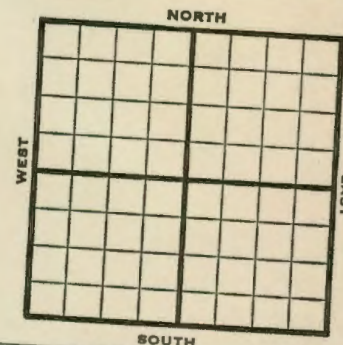

1952 Elev. 2649'

REPORT

2/13

Location

2/20

MI

3/5

Topeka 3499'

Heeb 3662'

Lans. 3701'

D & A - Hold

3/12

Spnd 2-19-52

D&A TD 4210

8" @ 262

Anky 2260

Heeb. 3662

B KC 3910

Arb. 4177

TD 4210

D&A

Top. 3499

Lans. 3701

Cong. 4128


ABANDONED

County Decatur State
 Sec. 26 (Blk.) (Twp. 5) (Sur. 27W) (Rge.) Map No.

Operator Harry Gore

Well No. 1 Farm Feeby

Elev. 2649 Location NW NW NE

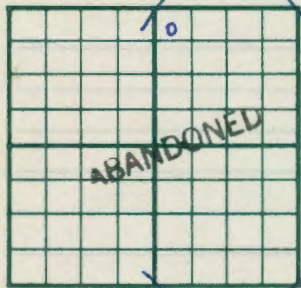

330 Ft. From N Line NE

330 Ft. From W Line Quarter

1st. Report

Completion MAR 12 1952

Remarks Wildcat

Spudding Date 2-19-52

Drig. Data D & A TD 4210

8" @ 262 Anhy 2260 Top. 3499

Heeb. 3662 Lans. 3701 B KC 3910

Cong. 4128 Arb. 4177 TD 4210

D & A


County Decatur State Kansas

Sec. 26 (Blk.) (Twp. 5) (Sur. 27W) (Rge.) Map No.

Operator Harry Gore

Well No. 1 Farm Feeby

Elev. Location NW NW NE

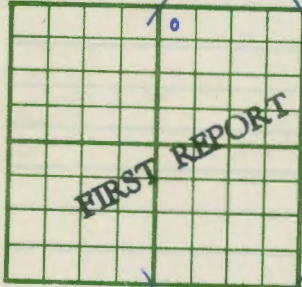

330 Ft. From N Line NE

330 Ft. From W Line Quarter

1st. Report FEB 13 1952

Completion

Remarks

Spudding Date

Drig. Data

Wildcat

Location

J. G. McGEHEE