


Section 27 Township 5 Range 27 W

Well No. # 1 Feely

Company Lohman & Johnson

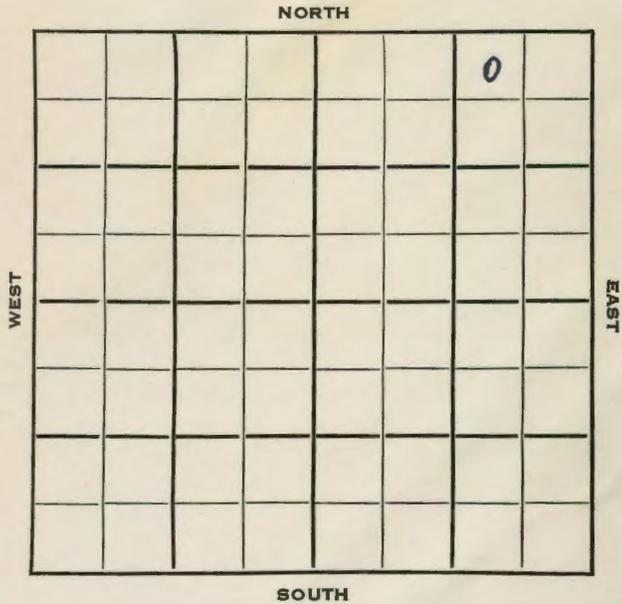

Sec. 27 Twp. 5 R. 27W

Well No. #1 Feely Farm _____

Lohman & Johnson Company


Lohman & Johnson Contractor

330 Ft. from N. Line

_____ Ft. from S. Line

990 Ft. from E. Line

_____ Ft. from W. Line

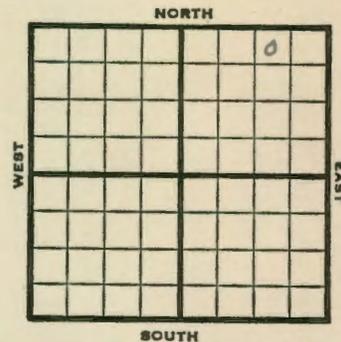

NW NE NE
Cont'l farmout

1953 **Elev. 2661'** REPORT

6/3 Spud 5-31-53
8" @ 194'
Drlg 1875'

6/10 Spud 5-31-53
D & A
TD 3910'
8" @ 194'
Anhy 2266', Top 3462, Heeb 3649, Tor 3670, Lans 3688
DST 3673-3704 opn 1 hr, rec 4' mud,
DST 3721-48 opn 1 hr, rec 20' mud
Marm 3888'
TD 3910'
D & A

ABANDONED

