

Sec. 27 Twp. 5 R. 27W ✓Well No. #1 Gillispie (A) FarmContinental Company


Contractor

Ft. from N. Line

330 Ft. from S. Line990 Ft. from E. Line

Ft. from W. Line


SW SE SE

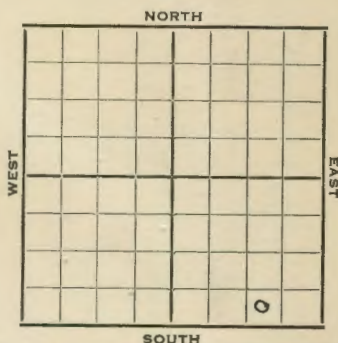

1952 Elev. 2657' REPORT

- 3/5 Spud 2-27-52
10" @ 247'
Drlg. 3090'
- 3/12 Heeb 3610'
Lans. 3649'
RTD 3880' 5" @ 3879' WOC
- 3/19 Electric log CO to 3843
2/3795 B/muddy wtr 4 hrs.
16/3825-41 S/1/2 BO & SSW
PH for 12 hrs. S/1/2 BOPH for 18 hrs
to A
- 3/25 2/3764-dry 32/3746-53 S/ 1/3
BWPH for 8 hrs. PB 3770
Sqz. off Drlg. 3880'
- 4/1 TD 3880 PB 3788 DP to 3788 dry
40/3768-78 bail 1/3 bwph for 12 hrs.
PB 3762 32/ 3735-42 B 1/3 bwph
for 12 hrs. set retainer 3728
sq. off 2/3716 B wtr. set reatiner
3710 sq. off.
- 4/9 CO to 3728 32/3720-28 B/trace wtr
500A S/ 1/2 BO & 2 bwph S/ 12 BO &
45 BWPH set plug 3709 80/ 3680-3700
S/16 BO & 4 BWPH
- 4/23 Spud 2-27-52
Oil Well TD 3880 10" @ 247'
Heeb. 3610 Lans. 3649
TD 3880 5" @ 3879 CO to 3843

OVER

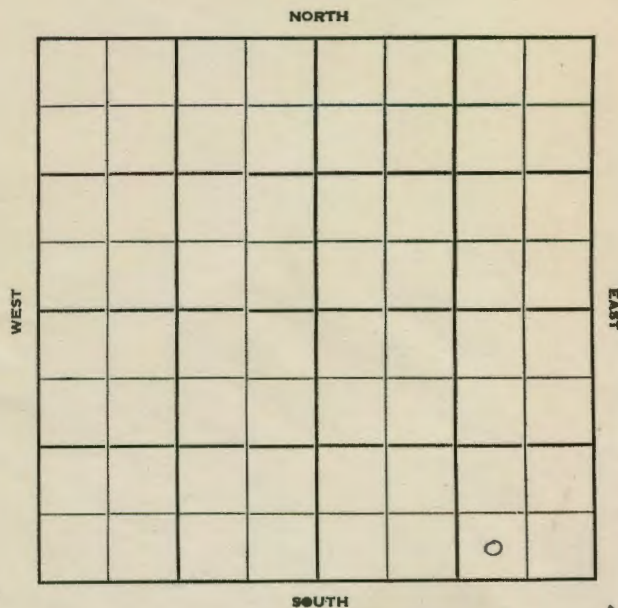Section 27 Township 5 Range 27WWell No. #1 Gillispie (A)Company Continental

16

1952

4/23 2/ 3795- B/ muddy wtr. 16/ 3804-08
B/ dry 64/ 3825-41 S/ $\frac{1}{2}$ bo & SSW
S/ $\frac{1}{2}$ boph 18 hr. 2/ 3764 dry
32/ 3746-53 S/ 1/3 bwph 8 hr.
PB 3770 TD 3880 PB 3788 40/ 3768-78
B/ 1/3 bwph 12 hr. PB 3762
32/ 3735-42 B/ 1/3 bwph 12 hr.
SP 3728 w/ 3716 B wtr SP 3710
CO to 3728 32/ 3720-28 B/ tr. oil
500 A S/ $\frac{1}{2}$ bo 2 bwph S/ 12 bo
45 bwph SP 3709 80/ 3680-3700
S/ 16 bo 4 bwph PB 3672
64/ 3648-64 S/ $1\frac{1}{2}$ boph 8 hr.
500 A B/ 9 boph 11 hr. S/ $7\frac{1}{2}$ boph
6 hr. DP to 3709 S/ 20 boph 4
bwph 6 hr. Comp. 493 bopd
3% wtr.

COMPLETED

County **Decatur** State **Kansas**
 Sec. **27** (Blk. Twp.) **5** (Sur. Rge.) **27W** Map No.
 Operator **Continental**
 Well No. **1** Farm **Gillispie (A)**
 Elev. Location **SW SE SE**

330	Ft. From	S	Line	SE
990	Ft. From	E	Line	Quarter

 1st. Report **MAR 5 1952**
 Completion
 Remarks
 Spudding Date **2-27-52**
 Drlg. Data
10" @ 247 Drlg. 3090

J. G. McGEHEE

County **Decatur** State **Kansas**
 Sec. **27** (Blk. Twp.) **5** (Sur. Rge.) **27W** Map No.
 Operator **Continental**
 Well No. **1** Farm **Gillispie "A"**
 Elev. **2657** Location **SW SE SE**

330	Ft. From	S	Line	SE
990	Ft. From	E	Line	Quarter

 1st. Report
 Completion **APR 23 1952**
 Remarks
 Spudding Date **2-27-52**
 Drlg. Data **Oil well TD 3880**
10" @ 247 Heeb. 3610 Lans. 3649
TD 3880 5" @ 3879 CO to 3843
2/ 3795- B/ muddy water 16/ 3804-08
B/ dry 64/ 3825-41 S/ $\frac{1}{2}$ bo & SSW
S/ $\frac{1}{2}$ boph 18 hr. 2/ 3764 dry
32/ 3746-53 S/ $\frac{1}{3}$ bwph 8 hr.
PB 3770 TD 3880 PB 3788 40/ 3768-78
B/ $\frac{1}{3}$ bwph 12 hr. PB 3762 32/ 3735-42
B/ $\frac{1}{3}$ bwph 12 hr. SP 3728 2/ 3716
B/ water SP 3710 CO to 3728 32/ 3720-
28 B/ tr. oil 500 A S/ $\frac{1}{2}$ bo 2 bwph
S/ 12 bo 45 bwph SP 3709 80/ 3680-3700
S/ 16 bo 4 bwph PB 3672 64/ 3648-64

J. G. McGEHEE

T. C. WOODHILL

Orig. Date

S/ $1\frac{1}{2}$ boph 8 hr. 500 A B/ 9 boph

11 hr. S/ $7\frac{1}{2}$ boph 6 hr. DP to 3709

S/ 20 boph 4 bwph 6 hr.

Comp. 493 boph 3% water

APR 30 1952

Scout Cards
Land Small Map
Land Wall Map
Tracings
France Map
Pierce Map
Misc