


Section 27 Township 5 Range 27W

Well No. #2 George Gillispie (A)

Company Continental Oil

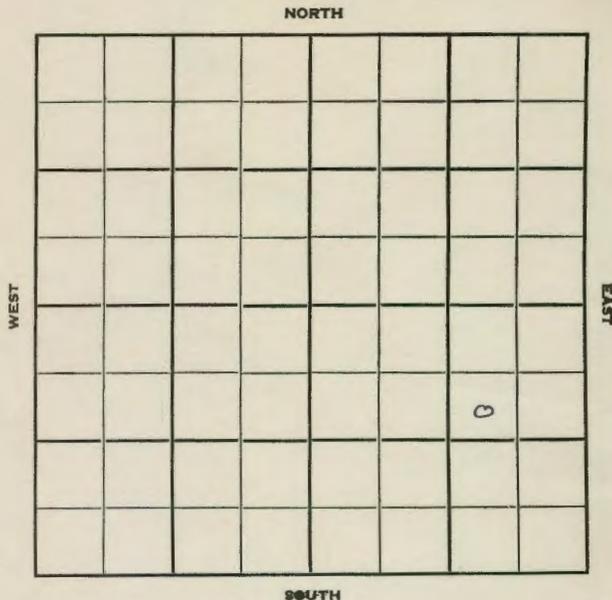

9

Sec. 27 Twp. 5 R. 27W

Well No. #2 George Gillispie (A) Farm

Continental Oil Company

Contractor


Ft. from N. Line

1650 Ft. from S. Line

990 Ft. from E. Line

Ft. from W. Line

SW NE SE

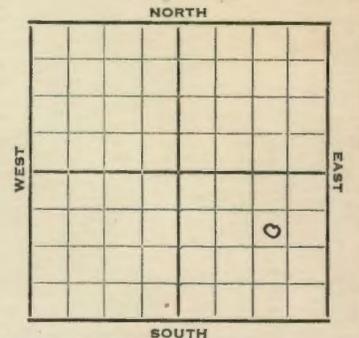

1952 **Elev. 2634'** REPORT

- 4/9 Spud 4-1-52
10" @ 251'
Anhy 2234
Drlg.
- 4/23 RTD 3720' 5" @ 3719'
Schl tops: **Topeka 3424'** **Heeb 3608'**
Lans. 3647'
- 4/30 WOCT
- 5/7 DP 3684' 24/ 3648-56 S/ 1/2 BO &
2 BWPH for 12 hrs. B/ 1/2 BO & 1 BWPH
for 24 hrs. 250 A S/ 20 BO & 60 BW
12 hrs. S/ 36 BO & 108 BW 24 hrs.
S/ 38 BO & 110 BW 24 hrs. from
3648'-56'
- 5/14 S/38 BOPD POP
- 5/20 NR
- 5/28 "
- 6/11 "
- 6/18 "
- 6/25 Spud 4-1-52
Oil Well TD 3720 10" @ 251'
Anhy 2234 **Heeb. 3608**
Lans. 3647'
DST 3648-58 open 1 hr. rec. 135' oil
35' w tr.

OVER

1952

6/25 DST 3677-3710 open 1 hr. rec.
1400' sw TD 3720 5" @ 3719
Top. 3424 24/ 3648-56
S/ $\frac{1}{2}$ bo 2 bwph B/ $\frac{1}{2}$ bo 1 bwph
250 A S/ 20 bo 60 bw 12 hr.
S/ 36 bo 108 bw 24 hr. S/ 38 bo
110 bw 24 hr. S/ 38 bopd
Comp. 99 bopd 70% wtr.

COMPLETED

