


Section 27 Township 5 Range 27 W

Well No. #3 Geo. Gillispie (A)

Company Continental Oil

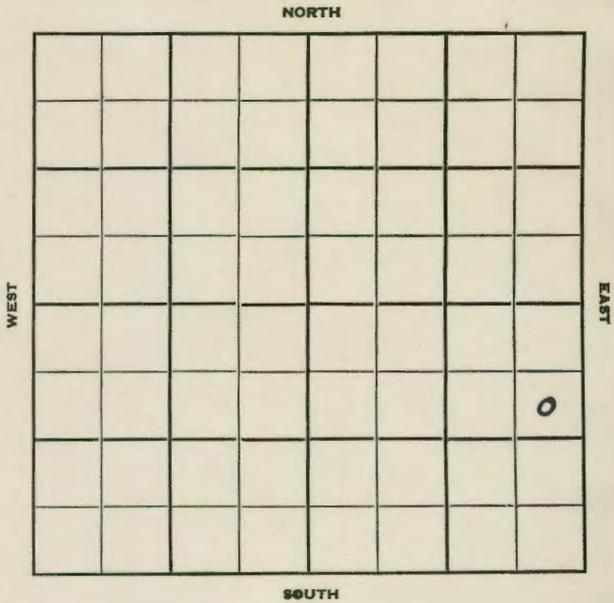

9

Sec. 27 Twp. 5 R. 27 W

Well No. #3 Geo. Gillispie (A) Farm

Continental Oil Company

Contractor


990 Ft. from N. Line

_____ Ft. from S. Line

330 Ft. from E. Line

_____ Ft. from W. Line

SE NE SE

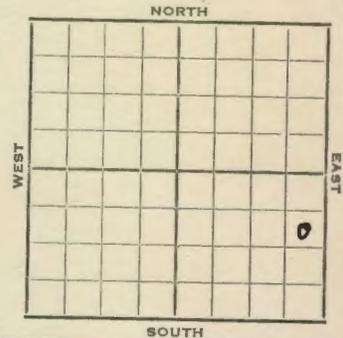

1952 ^{2627'} Elev. ~~2640'~~ ^{RB} REPORT

- 4/30 Spud 4-24-52
10" @ 248'
Anhy 2230'
Drlg. 3040'
- 5/7 DST 3647-64 1 hr. 12' HOCM 50' m
1160# FP O#
DST 4011-27 1 hr. 10' m O#
Drlg. 4079'
- 5/14 Schl tops: **Topeka 3423'** **Heeb 3607'**
Tor. 3631' **Lans. 3648'**
Sample tops: **Marm 3846'** **Cong. 4085'**
Arb. 4091'
RTD 4144' 5" @ 4098 WOCT
- 5/20 "
- 5/28 DP 4026 42/3648-64 S/scum oil
plus 3 BWPH. Set packer 3620'
Sq off DC
- 6/11 Spud 4-24-52
SWD well TD 4200' 10" @ 248
Anhy 2230'
DST 3647-64 open 1 hr. rec 12' HOCM
50' mud
DST 4011-27 open 1 hr. rec 10' mud
Top. 3423' **Heeb 3607'** **Tor. 3631'**
Lans. 3648' **Marm 3846'** **Cong. 4085'**
Arb. 4091' TD 4144' 5" @ 4098'
DP to 4026' 42/3648-64 S/scum oil
3 BWPH SP 3620 DD 4200
Comp. for SWD well
ABANDONED

County Decatur State Kansas
 Sec. 27 (Bk. 5 (Sur. 27W Map No.
 Operator Continental Oil
 Well No. 3 Farm Geo Gillispie (A)
 Elev. 2640 RB Location SE NE SE

FIRST REPORT

990 Ft. From N Line SE
330 Ft. From E Line Quarter
 Ist. Report APR 30 1952
 Completion _____
 Remarks _____
 Spudding Date 4-24-52

Drlg. Data
10" @ 248 Anhy 2230 Drlg. 3040

J. G. McGEHEE

County Decatur State Kansas
 Sec. 27 (Bk. 5 (Sur. 27W Map No.
 Operator Continental Oil
 Well No. 3 Farm Geo. Gillispie "A"
 Elev. 2627 Location SE NE SE

ABANDONED

990 Ft. From N Line SE
330 Ft. From E Line Quar
 Ist. Report _____
 Completion JUN 11 1952
 Remarks _____
 Spudding Date 4-24-52

Drlg. Data SWD well TD 4200
10" @ 248 Anhy 2230 DST 3647-64
open 1 hr. Rec. 12' hocm 50' mud
DST 4011-27 open 1 hr. Rec. 10' mud
Top. 3423 Heeb. 3607 Tor. 3631
Lans. 3648 Marm. 3846 Cong. 4085
Arb. 4091 TD 4144 5" @ 4098
DP to 4026 42/ 3648-64 S/ scum oil
3 bwph SP 3620 DD 4200
Comp. for SWD well

J. G. McGEHEE