


Decatur **KANSAS**

Section 27 Township 5 Range 27W

Well No. 1 Tice

Company Cities Service Oil

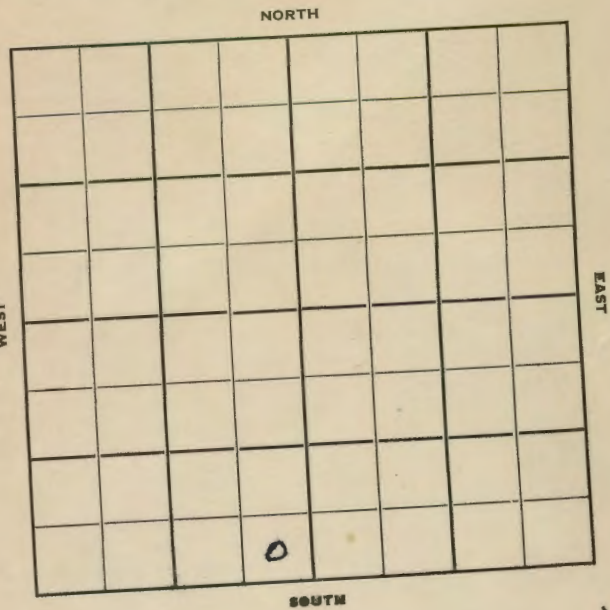

14

Decatur **KANSAS**

Sec. 27 Twp. 5 R. 27W

Well No. # 1 Tice Far

Cities Service Oil Compan

Lohman & Johnson Contracto

Wildcat


Ft. from N. Line

330 Ft. from S. Line

330 Ft. from E. Line

Ft. from W. Line

SE SE SW

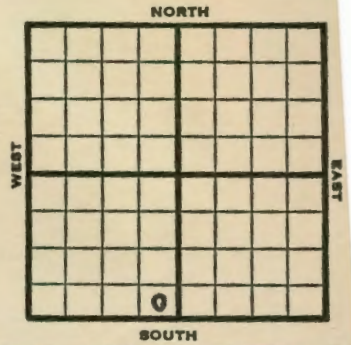

1952

Elev. 2690'

REPORT

12/17 RUR

12/18 RUR

12/29 RUR

1953

1/7

Spud 12-16-52

D & A TD 3975' 8" @ 202

Top 3507' Heeb 3689' Dodge 3712'

Lans. 3726' Stain 3726-32'

DST 3717-37 open 1 hr. rec 14' mud 330#

DST 3742-74 open 1 hr. rec 15' mud 400#

B KC 3928' TD 3975'

D & A

ABANDONED

