

Decatur

KANSAS

Sec. 34 Twp. 5 R. 27W

Well No. #1 Geo. Gillispie (B) Farm

Continental Oil Company

Long & Johnson - Contr. Contractor


330' Ft. from N. Line

Ft. from S. Line

330' Ft. from E. Line

Ft. from W. Line

NE NE SE

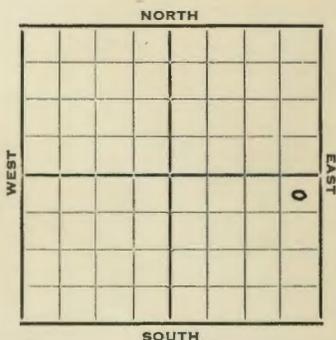

1952 **Elev. 2651'** REPORT

4/16 Spud 4-14-52

10" @ 247'

4/22 Drlg. 3810'

4/30 **Topeka 3403 Heeb. 3589**

Lans. 3626 Marm 3826

RTD 2870 5" @ 3869 WOCT

5/7 NR

5/14 36/3794-3806' B/1/2 BOPH for 8 hrs.

15/3776-81 S/5 BOPH for 8 hrs. 500 A

S/23 BOPH for 4 hrs. 36/3738-50

S/27 BOPH for 4 hrs. Set plug 3730'

41/3712-26 S/2 BO & 6 BWPB for 14 hrs.

24/3694-2702 S/23 BO & 6 BWPB

66/3656-78 S/35 BO & 6 BWPB for 6 hrs.

5/21 Spud 4-14-52 Oil Well TD 3870'

10" @ 247' **Anhy 2227 Top. 3403**

Heeb. 3589 Lans. 3626 Marm 3826

TD 3870 5" @ 3869' 36/ 3794-3806

B/ 1/2 boph 15/ 3776-81 S/ 5 boph 8 hr.

500 A S/ 23 boph 4 hr. 36/ 3738-50

S/ 27 boph 4 hr. SP 3730 41/ 3712-26

S/ 2 bo 6 bwph 24/ 3694-3702

S/ 23 bo 6 bwph 66/ 3656-78 S/ 35 bo

6 bwph 52/ 3626-54 S/ 26 bo 6 bwph

18 hr. DP 3837 S/ 40 bo 6 bwph

6 hr. Comp. BHB 3000 bopd


COMPLETED

KANSAS

Section 34 Township 5 Range 27W

Well No. #1 Geo. Gillispie (B)

Company Continental Oil

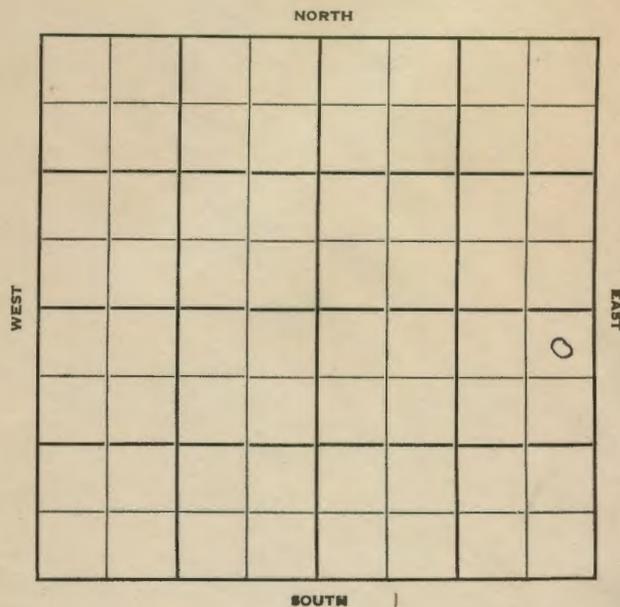

9

County Decatur State Kansas
 Sec. 34 (Blk. 5 (Sur. 27W Map No.
 Operator Continental Oil
 Well No. 1 Farm Geo. Gillispie "B"
 Elev. 2651 Location NE NE SE

330 Ft. From N Line SE
330 Ft. From E Line Quarter
 Ist. Report
 Completion MAY 21 1952
 Remarks
Long & Johnson - Contr.
 Spudding Date 4-14-52

Drig. Data Oil well TD 3870
10" @ 247 Anhy 2227 Top. 3403
Heeb. 3589 Lans. 3626 Marm. 3826
TD 3870 5" @ 3869 36/ 3794-3806
B/ 1/2 boph 15/ 3776-81 S/ 5 boph 8 hr.
500 A S/ 23 boph 4 hr. 36/ 3738-50
S/ 27 boph 4 hr. SP 3730 41/ 3712-26
S/ 2 bo 6 bwph 24/ 3694-3702 S/ 23 bo
6 bwph 66/ 3656-78 S/ 35 bo 6 bwph
52/ 3626-54 S/ 26 bo 6 bwph 18 hr.
DP 3837 S/ 40 bo 6 bwph 6 hr.
Comp. BHB 3000 bopd

J. G. McGEHEE

County Decatur State Kansas
 Sec. 34 (Blk. 5 (Sur. 27W Map No.
 Operator Continental Oil
 Well No. 1 Farm Geo. Gillispie (B)
 Elev. Location NE NE SE

330 Ft. From N Line SE
330 Ft. From E Line Qua
 Ist. Report APR 16 1952
 Completion
 Remarks
Long & Johnson - Contr.
 Spudding Date 4-14-52

Drig. Data 10" @ 247

J. G. McGEHEE