


Section 34 Township 5 Range 27 WWell No. # 2 Geo. Gillispie (B)Company Continental Oil

NORTH

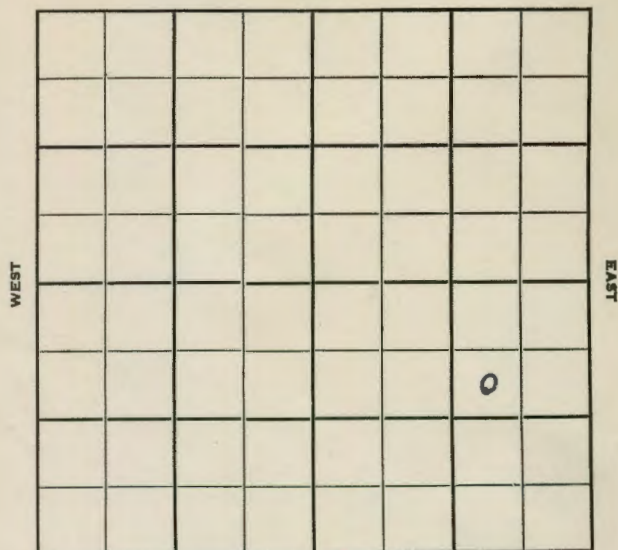

SOUTH

9.

Sec. 34 Twp. 5 R. 27WWell No. #2 Geo Gillispie (B) FarrContinental Oil Compan

Contracto

Adell NW

990' Ft. from N. Line


Ft. from S. Line

990' Ft. from E. Line

Ft. from W. Line

SW NE SE

NORTH

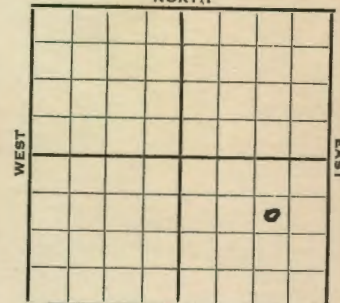

SOUTH

1952 **Elev. 2659'** REPORT

9/17 RU

9/24 10" @ 238 **Anhy 2242'**
Drlg. 3100'

10/1 **Heeb 3613, KC 3648**
DST 3765-75 1 hr., 660' SW 770#
FP 520 RTD 3775 7" @ 3762

10/8 24/3734-46 fill up 900' wtr. sq off
24/3715-26, S/3 BO & 1/3 BWPH sq off

10/15 12/3636-4 N/S Sq off, CO to 3707
58/3678-3700, S/9 BO & 3 BWPH
43/3650-66, 500A, S/20 BO & 13 BWPH
WOP

10/22 Spud 9-16-52
OilWell
TD 3775'
10" @ 238'
Anhy 2242', Heeb. 3612', KC 3648'
DST 3765-75, opn 1 hr., rec. 660' SW
770#
TD 3775
7" @ 3762
24/3734-46, FU 1900' water
24/3715-26 S/3 bo 1/3 bwph 12 hrs.
S/ 1 bo 1 1/2 bwph 12 hrs. 12/3636-40
CO to 3707 58/3678-3700 S/9 bo 3 bw
ph 3 hrs., 43/3650-66 S/11 bo 3 bwph
S/8 bo 3 bwph 500A S/20 bo 13 bwph
Comp. 831 bopd 30% wtr.

COMPLETED

County Dodder State Kansas

Sec. **34** (Blk.) **5** (Sur.) **27W** Map No.

Operator Continental Oil

Well No. **2** Farm **Geo Gillispie (B)**

Elev.	Location	SW	NE	SE
-------	----------	----	----	----

990 Ft. From N Line SE

990 Ft. From **E** Line Quarter

1st. Report SEP 17 1952

Completion

Remarks

Spudding Date

Drq. Data Adell NW

RTU

J. G. McGEHEE

County Decatur State Kansas

Sec. 34 (Blk.) 5 (Sur.) 27W Map No.

Operator Continental Oil

Well No. 2 Farm Geo. Gillispie "B"

Elev.	2659	Location	SW NE SE
-------	------	----------	----------

990 Ft. From N Line SE

990 Ft. From E Line Quarter

1st. Report

Completion OCT 22 1952

Remarks	NW Adell Pool
---------	---------------

Spudding Date 9-16-52

Drilg. Data Oil well TD 3775

10" @ 238 Anhy 2242 Heeb. 3612

KC 3648 DST 3765-75 open 1 hr.

Rec. 660' s w 770# TD 3775 7" @ 3762

24/ 3734-46 FU 1900' water 24/ 3715-26

S/ 3 bo 1/3 bwph 12 hr. S/ 1 bo

1½ bwph 12 hr. 12/ 3636-40 CO to 3707

58/ 3678-3700 S/ 9-bo 3 bwpb 3 hr.

43/ 3650-66 S/ 11 bo 3 bwph S/ 10 bo

3 bwph 500 A S/ 20 bo 13 bwph

Comp. 831 bopd 30% wtr.

J. G. McGEHEE