

Decatur **KANSAS** ✓Sec. 34 Twp. 5 R. 27 WWell No. # 1 Helmers FarmBarnett Drlg. Company

Contractor

Wildcat

330 Ft. from N. Line


Ft. from S. Line

330 Ft. from E. Line

Ft. from W. Line

NE NE SW

Magnolia Farmout

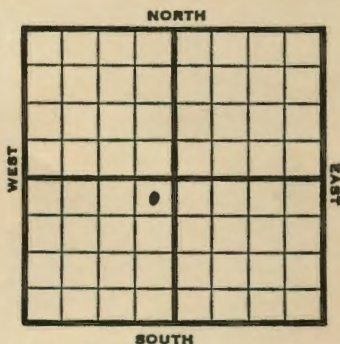

1952 Elev. 2630' REPORT

12/17 Spud 12-16-52
8" @ 206 WOC

12/18 " " "

12/25 8" @ 206

12/30 Spud 12-16-52

D&A

TD 4010'

8" @ 206

Anhy 2360, Heeb 3791, Mans
3832DST 3835-56, opn $\frac{1}{2}$ hr., rec.


25' wtr. 1058#

DST 3858-3915, opn 1 hr., rec.

30' mud, 660#

TD 4010

D&A

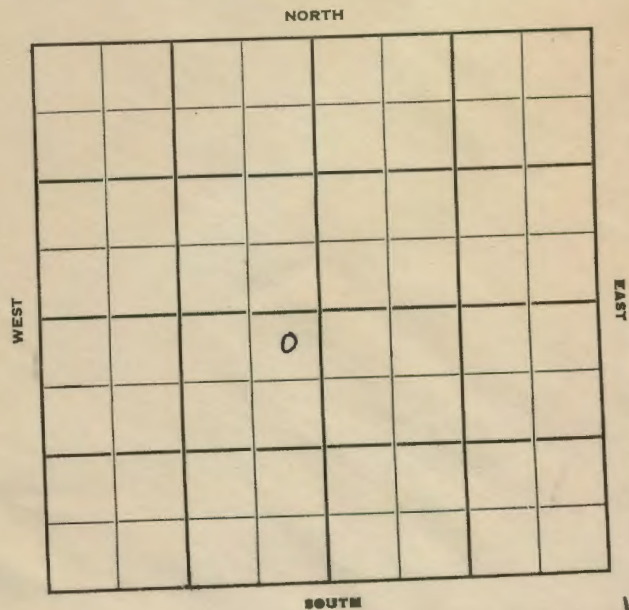ABANDONEDDecatur **KANSAS**Section 34 Township 5 Range 27WWell No. 1 HelmersCompany Barnett Drlg.

11

County **Decatur** State **Kansas**
 Sec. **34** (Blk. **5** (Sur. **27W** Map No.
 Operator **Barnett Drlg.**
 Well No. **1** Farm **Helmers**
 Elev. Location **NE NE SW**
330 Ft. From **N** Line **SW**
330 Ft. From **E** Line Quarter
 Ist. Report **DEC 17 1952**
 Completion
 Remarks **Magnolia farmout**
 Spudding Date **12-16-52**
Wildcat

Drlg. Data
8" @ 206 WOC

J. G. McGEHEE

County **Decatur** State **Kansas**
 Sec. **34** (Blk. **5** (Sur. **27W** Map No.
 Operator **Barnett Drlg.**
 Well No. **1** Farm **Helmers**
 Elev. **2630** Location **NE NE SW**
330 Ft. From **N** Line **SW**
330 Ft. From **E** Line Quarter
 Ist. Report
 Completion **DEC 30 1952**
 Remarks **Wildcat**
 Spudding Date **12-16-52**

Drlg. Data **D & A TD 4010**

8" @ 206 Anhy 2360 Heeb. 3791

Lans. 3832 DST 3835-56 open $\frac{1}{2}$ hr.

Rec. 25' wtr. 1058# DST 3858-3915

open 1 hr. Rec. 30' mud 660# TD 4010

D & A

J. G. McGEHEE