


Section 35 Township 5 Range 27W

Well No. 1 Bowman

Company R. W. Shields

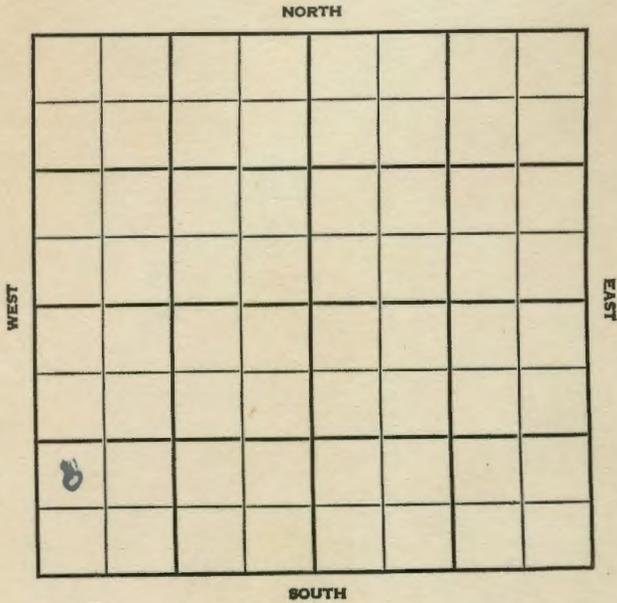

13

SEC. 35 TWP. 5 R. 27 W

WELL NO. # 1 Bowman FARM

COMPANY R. W. Shields

CONTRACTOR Barnett


NW Adel Pool

990 Ft. from N. Line

330 Ft. from S. Line

330 Ft. from E. Line

NW SW SW Ft. from W. Line

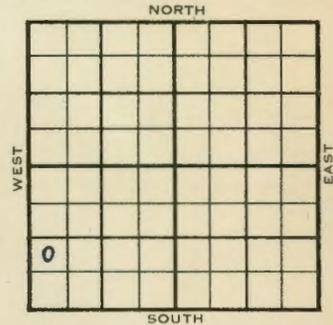

	ELEVATION	REPORT
1954	2617'	

10/27 Spud 10-21-54  
8" @ 202  
Anhy 2215'  
Drlg. 2620'

11/3 Spud 10-21-54  
D & A  
TD 3868'  
8" @ 202'  
Anhy 2215', Heeb 3598' KC 3636'  
DST 3667'-91' opn 1 hr, rec 20' wtry mu  
860#  
TD 3868'  
D & A

**ABANDONED**

County Decatur State Kansas  
Sec. 35 (Blk. 5 (Sur. 27W Map No.  
Operator R. W. Shields  
Well No. 1 Farm Bowman  
Elev. 2617 Location NW SW SW

FIRST REPORT			

990 Ft. From S Line SW  
330 Ft. From W Line Quarter  
1st. Report OCT 27 1954  
Completion \_\_\_\_\_  
Remarks Barnett - Contr.  
Spudding Date 10-21-54

Drlg. Data NW Adel Pool  
8" @ 202 Anhy 2215 drlg. 2620

FABEN GILSTRAP

County Decatur State Kansas  
Sec. 35 (Blk. 5 (Sur. 27W Map No.  
Operator R. W. Shields  
Well No. 1 Farm Bowman  
Elev. 2617 Location NW SW SW

ABANDONED			

990 Ft. From S Line SW  
330 Ft. From W Line Quarter  
1st. Report \_\_\_\_\_  
Completion NOV 3 1954  
Remarks NW Adel Pool  
Barnett - Contr.  
Spudding Date 10-21-54

Drlg. Data D & A TD 3868  
8" @ 202 Anhy 2215 Heeb. 3598  
KC 3636 DST 3667-91 open 1 hr. Rec.  
20' wtry mud 860# TD 3868  
D & A

FABEN GILSTRAP