
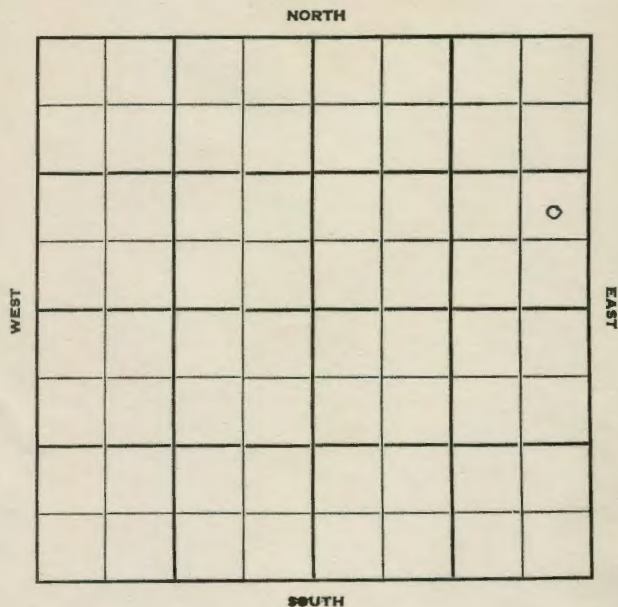


Section 34 Township 5 Range 27WWell No. #1 GillespieCompany Continental Oil

8

Sec. 34 Twp. 5 R. 27WWell No. #1 Gillespie Farm ☒Continental Oil CompanyLohman & Johnson ContractorWildcat         Ft. from N. Line990 Ft. from S. Line330 Ft. from E. Line         Ft. from W. Line

NE SE NE

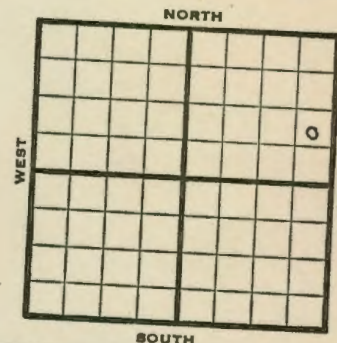

1951

Elev. 2661'

REPORT

12/5

Spud 12-2-51

10" @ 232'

Drlg. 1495'

1952

1/16

Spud 12-2-51

Oil Well TD 4075 10" @ 232'

Heeb. 3593 Tor. 3641'

DST 3611-27 open 1 hr. rec. 5' hvy black oil 30' HOCM KC 3633'

DST 3634-42 open 1 hr. rec. 10' mud Lans. 3633 DST 3662-78 open 1 hr.

Rec. 3392' clean oil Marm. 3862

Gr. wash 4032 TD 4075 7" @ 3891

CO to 3850 38/ 3805-20 S/ 115 BO

7 hr. S/ 347 BO 23 hr. 48/ 3750-62 FU 3150' oil S/ 156 BO 3 1/2 hr.

SP 3742 96/ 3702-38 S/ 5 1/2 BO

3/4 BWPB S/ 8 BO 1/2 BWPB SP 3694

76/ 3664-86 S/ 70 BOPB PB 3656

72/ 3632-50 S/ 60 BOPB SP 3656

S/ 6 BOPB CO to 4075

Comp. 1192 BOPB

COMPLETED

County **Decatur** State **Kansas**  
 Sec. **34** (Blk.) **5** (Sur.) **27W** Map No.  
 Operator **Continental Oil**  
 Well No. **1** Farm **Gillespie**  
 Elev. \_\_\_\_\_ Location **NE SE NE**  
 990 Ft. From **S** Line **NE**  
 330 Ft. From **E** Line Quarter  
 1st. Report **DEC 5 1951**  
 Completion \_\_\_\_\_  
 Remarks \_\_\_\_\_  
**Lohman & Johnson - Contr.**  
 Spudding Date **12-2-51**

Drlg. Data **Wildcat**  
**10" @ 232 drlg. 1495**

J. E. TYRA

County **Decatur** State **Kansas**  
 Sec. **34** (Blk.) **5** (Sur.) **27W** Map No.  
 Operator **Continental Oil**  
 Well No. **1** Farm **Gillespie**  
 Elev. **2661** Location **NE SE NE**  
 990 Ft. From **S** Line **NE**  
 330 Ft. From **E** Line Quarter  
 1st. Report \_\_\_\_\_  
 Completion **JAN 16 1952**  
 Remarks **Wildcat**  
**Lohman & Johnson - Contr.**  
 Spudding Date **12-2-51**

Drlg. Data **Oil well TD 4075**  
**10" @ 232 Heeb. 3593 Tor. 3611**  
**DST 3611-27 open 1 hr. Rec. 5' hvy**  
**black oil 30' hoom KC 3633 DST 3634-**  
**42 open 1 hr. Rec. 10' mud Lans. 3633**  
**DST 3662-78 open 1 hr. Rec. 3392'**  
**clean oil Marm. 3862 Gr. wash 4032**  
**TD 4075 7" @ 3891 CO to 3850**  
**38/ 3805-20 S/ 115' bo. 7 hr.**  
**S/ 347 bo 23 hr. 48/ 3750-62**  
**FU 3150' oil S/ 156 bo 3½ hr.**  
**SP 3742 96/ 3702-38 S/ 5½ bo 3/4 bwph**  
**S/ 8 bo ½ bwph SP 3694 76/ 3664-86**  
**S/ 70 boph PB 3656 72/ 3632-50**  
**S/ 60 boph SP 3656 S/ 6 boph**

J. E. TYRA



Drlg. Data

CO to 4075 Comp. 1192 bopd

JAN 23 1952

|                |
|----------------|
| Scout Cards    |
| Land Small Map |
| Land Wall Map  |
| Tracings       |
| France Map     |
| France Map     |
| Misc           |