


KANSAS

Section 34 Township 5 Range 27W

Well No. #3 Gillespie

Company Continental Oil

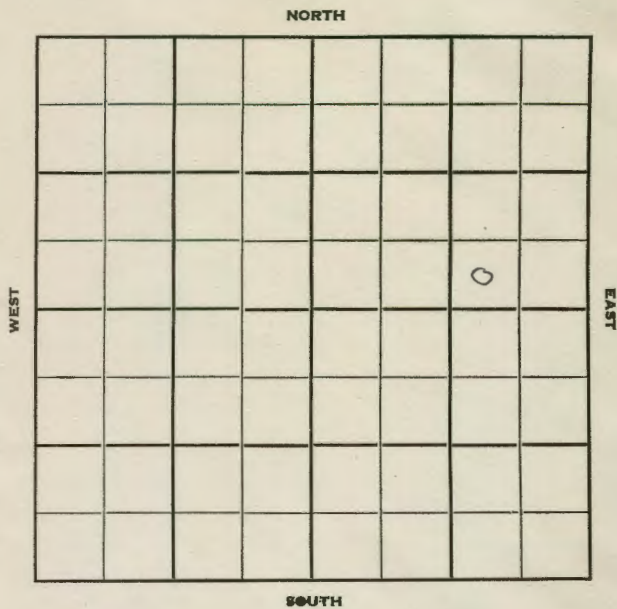

SOUTH

9

Decatur

KANSAS


Sec. 34 Twp. 5 R. 27W

Well No. #3 Gillespie Farm _____

Continental Oil Company _____

Contractor _____

_____ Ft. from N. Line
330' Ft. from S. Line
990' Ft. from E. Line
 _____ Ft. from W. Line

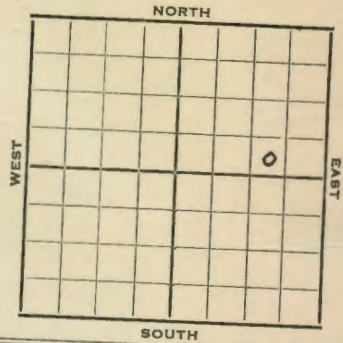

SW SE NE

1952 **Elev. 2669'** REPORT

3/19 Spud 3-15-52
 10" @ 248
 Drlg. 1660

3/25 Drlg. 3461'

4/1 Sch. tops: **Topeka 3412 Heeb. 3599**
Lans. 3637 Marm 3840 RTD 3885
 5" @ 3884 WOC

4/9 WOC

4/23 PB 3844' 18/3830-36 S/4 BOPH
 42/3808-22 S/1/2 BOPH 18/3788-3794
 S/2 BOPH 500 A S/245 BO plus 45 BW
 in 11 hrs. S/23 BO plus 3 1/2 BWPB
 PB 3775 36/3752-64 S/19 BO plus
 6 1/2 BWPB. S/28 BO plus 8 BWPB
 DP 3834' S/38 BO plus 8 BWPB
 Set plug 3746. 24/3730-38 S/34 BO
 plus 6 BWPB 72/3704-30 S/45 BOPB
 Set plug 3660' 48/3636-54 S/35 BOPB
 Drove plug to 3844' S/46 BOPB thru
 all perfs, tub & rods. 2260 BO plus
 244 BW.

4/30 NR
 5/7 *

OVER

1952

5/14 Spud 3-15-52
Oil Well TD 3885
10" @ 248' Top. 3412
Heeb. 3599 Lans. 3637
Marm. 3840 TD 3885
5" @ 3884 PB 3844 18/3830-36
S 1/4 boph 2 hr. 42/3808-22
S 1/2 boph 2 hr. 18/3788-3794
S/2 boph 6 hr. 500 A S/245 bo
45 bw 11 hr. S/23 bo 3 1/2 bwph
PB 3775 36/3752-64 S/19 boph
6 1/2 bwph 11 hr. S/28 boph 8 bw
DP 3834 S/38 bo 8 bwph SP 3746
24/3730-38 S/34 bo 6 bwph 13 hr.
72/3704-30 S/45 bo 7 bwph SP 3696
71/3666-90 48/3636-54 S/35 boph
DP 3844 S/46 boph Comp. BHB 2022
bopd 41 bw

COMPLETED

Dirig. Data

DP 3844 S/ 46 boph Comp. HHB 2022 bopd
41 bw

Scout Cards
Land Small Map
Land Wall Map
Tracings
France Map
Pierce Map
Misc.

APR 21 1952