


Section 34 Township 5 Range 27W

Well No. #4 Gillespie

Company Continental Oil

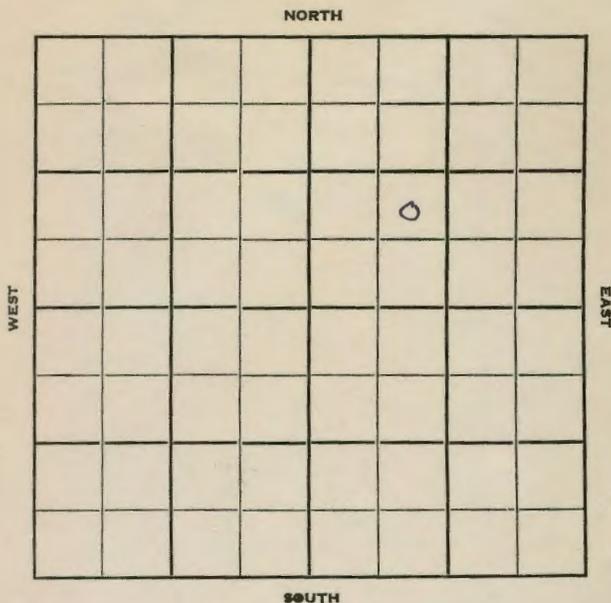

7

Sec. 34 Twp. 5 R. 27W

Well No. #4 Gillespie Farm

Continental Oil Company

Contractor


Ft. from N. Line

990 Ft. from S. Line

Ft. from E. Line

990 Ft. from W. Line

NE SW NE

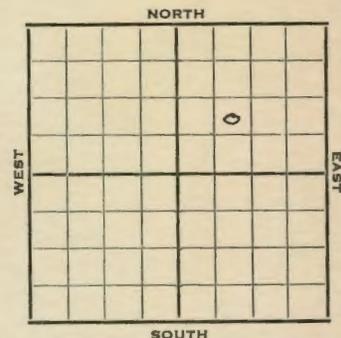

1952

REPORT

5/14 Spud 5-9-52  
 10" @ 248'  
**Anhy 2252**  
 Drlg. 2700'

5/20 Schl Top: **Heeb. 3616** **Lans. 3654**  
 RTD 3897 7" @ 3889 WOC

5/28 DP 3866' 24/3749-58 S/6½ BWPB  
 plus SSO for 8 hrs.  
**Marm 3853'** Set packer 3720' Sq off  
 DC 3866' 24/3827-36 24/3804-13  
 36/3768-82 S/3½ BOPB for 10 hrs.  
 To A

6/11 NR  
 6/18 NR  
 6/25 NR  
 7/2 "  
 7/9 "  
 7/17 "  
 7/23 Spud 5-9-52 Oil Well TD 3897  
 10" @ 248 **Anhy 2252** **Heeb. 3616**  
**Lans. 3654** TD 3897 7" @ 3889  
 DP to 3866 24/3749-58 S/6½ bwph  
 & SSO **Marm. 3853** SP 3720 sq. off  
**DC 3866** 24/3827-36 24/3804-13  
 36/3768-82 S/3½ boph 10 hr. 500 A  
 Comp. 2390 bopd

