
FORM 51 25M 8-50 WESTERN Decatur KANSAS

Section 34 Township 5 Range 27W

Well No. #5 Gillespie

Company Continental

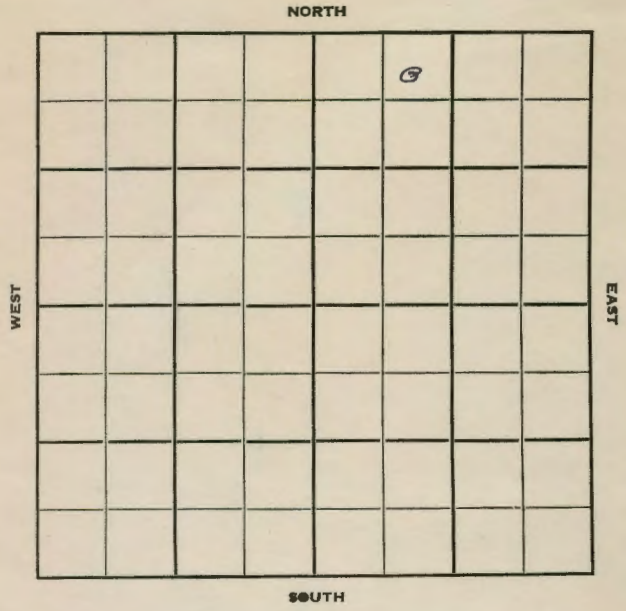

2

FORM 252-B
10M 8-51 TPCO. Decatur KANSAS

Sec. 34 Twp. 5 R. 27 W

Well No. # 5 Gillespie Farm

Continental Company

Contractor


330 Ft. from N. Line

Ft. from S. Line

Ft. from E. Line

990 Ft. from W. Line

NE NW NE

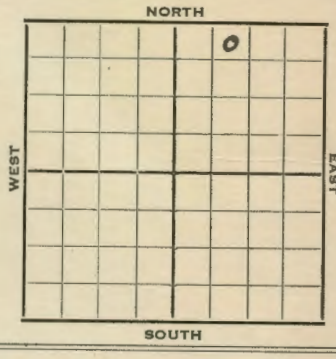

1952	Elev. 2685' DF REPORT
5/21	RU
5/28	10" @ 248' Anhy 2262' Drlg. 3391'
6/11	RTD 3915 7" @ 3909 DP 3894 24/3757-66 wtr & SSO 24/3836-45 12/3814-19 24/3778-88 S/2 BOPH from all perfs to A
6/18	500 A S/15 BOPH for 15 hrs. Set plug 3747' 24/3730-38' S/2 BOPH 40/3702-20 S/20 BOPH 24/3690-99 S/30 BOPH 48/3660-78 S/35 BOPH 250 A S/60 BOPH DP 3884' S/65 BOPH for 8 hrs. POP
6/25	NR
7/2	"
7/9	"
7/17	"

OVER

1952

7/23 Spud 5-21-52
Oil Well TD 3915
10" @ 248 Anhy 2262
Top 3436 Heeb. 3623
Lans. 3662 Marm 3862
TD 3915 7" @ 3909
DC 3894 SP 3884
24/3757-66 S/21½ bwph & SSO Sq off
CO to 3884 24/3836-45 S/3/4 boph
12/3814-19 S/1/4 boph 24/3778-88
S/3/4 boph S/2 boph 500 A
S/15 boph SP 3747 24/3730-38
S/2 boph 40/3702-20 S/20 boph
24/3690-99 S/30 boph 48/3660-78
S/35 boph 250 A S/60 boph DP 3884
S/65 boph Comp. BHB 1558 bopd

FORM 275 FOR SALE BY KANSAS BLUE PRINT CO.


County Decatur State Kansas

Sec. 34 (Blk. Twp.) 5 (Sur. Rge.) 27W Map No.

Operator Continental

Well No. 5 Farm Gillespie

Elev. 2685 DF Location NE NW NE

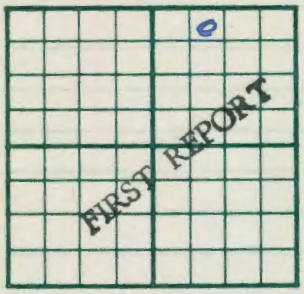

330 Ft. From N Line NE

990 Ft. From W Line Quarter

1st. Report MAY 21 1952

Completion

Remarks

Spudding Date

Drlg. Data

RU

J. G. McGEHEE

FORM 275 FOR SALE BY KANSAS BLUE PRINT CO.


County Decatur State Kansas

Sec. 34 (Blk. Twp.) 5 (Sur. Rge.) 27W Map No.

Operator Continental Oil

Well No. 5 Farm Gillespie

Elev. 2685 Location NE NW NE

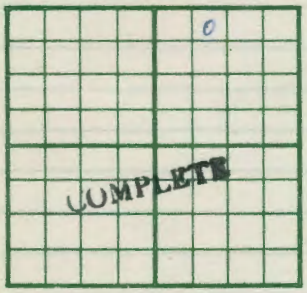

330 Ft. From N Line NE

990 Ft. From W Line Quarte

1st. Report

Completion JUL 23 1952

Remarks

Spudding Date 5-21-52

Drlg. Data Oil well TD 3915

10" @ 248 Anhy 2262 Top. 3436

Heeb. 3623 Lans. 3662 Marm. 3862

TD 3915 7" @ 3909 DC 3894 SP 3884

24/ 3757-66 S/ 21½ bwph & SSO sq off

CO to 3884 24/ 3836-45 S/ 3/4 boph

12/ 3814-19 S/ 1/4 boph 24/ 3778-88

S/ 3/4 boph S/ 2 boph 500 A

S/ 15 boph SP 3747 24/ 3730-38

S/ 2 boph 40/ 3702-20 S/ 20 boph

24/ 3690-99 S/ 30 boph 48/ 3660-78

S/ 35 boph 250 A S/ 60 boph DP 3884

S/ 65 boph Comp. BHB 1558 bopd

J. G. McGEHEE