


Section 35 Township 5 Range 27W

Well No. #1 Taylor

Company Continental Oil

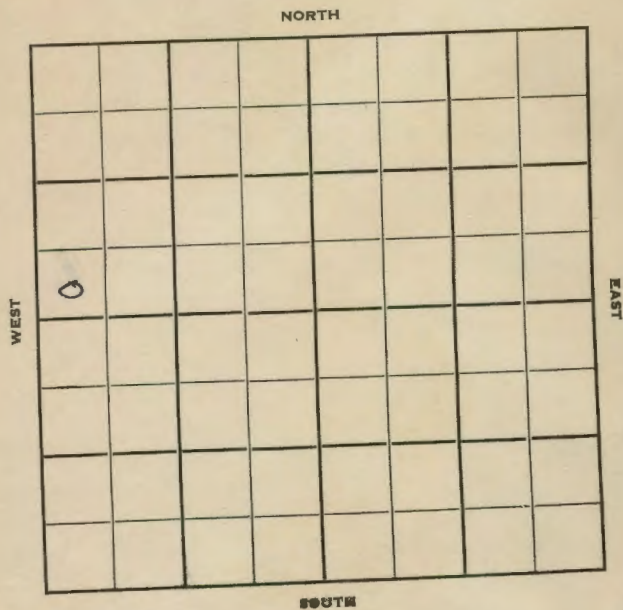

Sec. 35 Twp. 5 R. 27W

Well No. #1 Taylor Farm

Continental Oil Company

Lohman & Johnson Contractor

Dell


Ft. from N. Line

330 Ft. from S. Line

Ft. from E. Line

330 Ft. from W. Line

SW SW NW

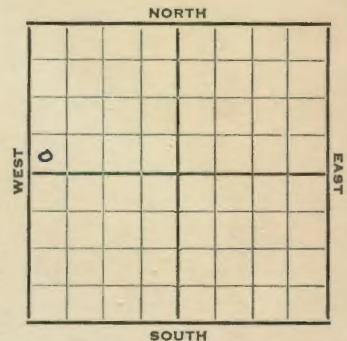

1952 Elev. 2639' REPORT

- 1/16 Spud 1-10-52
10" @ 247'
Anhy 2095'
Drlg. 2680'
- 2/6 **Heeb. 3588** **Lans. 3623**
Morm. 3831
RTD 3850 5" @ 3849
- 2/12 64/3718-34, S/5 BOPH & trace wtr
65/3800-16 S/6½ Boph & trace wtr
for 12 hrs. 500 A
S/257 BF in 7 hrs. 20% wtr
S/48 BF ph for 12 hrs. 20% wtr.
Land well plug 3768
S/34 BF ph for 12 hrs 20% wtr
- 2/20 S/10 BOPH for 10 hrs 20% wtr.
DP to 3821' Set plug 3714'
40/3698-3710
S/20 BFPH for 2 hrs, 20% wtr.
Increased to 50 BFPH 20% DP 3819'
Set plug 3686' S/6 BOPH
96/3658-84 S/48 BOPH for 10 hrs.
1000' off btm. PB 3648'
72/3626-44 S/6 BOPH for 12 hrs.
S/6 BOPH for 24 hrs. DP to 3817'
S/48 BOPH for 3 hrs. Rung tubg
& rods.

OVER

1952

2/27

Spud 1-10-52

Oil Well TD 3850

10" @ 247

Anhy 2095

Heeb. 3588

Lans. 3623

DST 3612-51 open 1 hr. rec. 590'

oil 180' HOMC

DST 3643-92 open 1 hr. rec. 105' OCM

DST 3692-3731 open 1 hr. rec. 130' OCM

1250' clean oil 240' OCM & wtr.

DST 3779-3815 open 1 hr. rec. 64' OCM

DST 3815-45 open 1 hr. rec. 10' OCM

Heeb. 3593

Lans. 3629

Marm. 3831

TD 3850 5" @ 3849 64/ 3718-34

S/ 5 boph 65/ 3800-16 S/ 6½ BOPH

12 hr. 500 A S/ 257 bf 7 hr.

20% wtr. S/ 48 bfph 12 hr.

SP 3768 S/ 34 bfph 12 hr.

S/ 15 boph 10 hr. DP 3821

sp 3714 40/ 3698p3710 S/ 20 bfph

2 hr. 20% wtr. inc. to 50 bfph

20% wtr. DP 3819 SP 3686

S/ 6 boph 96/ 3658-84 S/ 48 boph

PB 3648 72/ 3626-44 S/ 6 boph

12 hr. S/ 6 boph 24 hr. DP 3817

S/ 48 boph 3 hr.

Comp. 1137 bopd 37 BW

COMPLETED

Drig. Data

S/ 15 boph 10 hr. DP 3821 SP 3714

40/ 3698-3710 S/ 20 bfph 2 hr. 20% wate

inc. to 50 bfph 20% water DP 3819

SP 3686 S/ 6 boph 96/ 3658-84

S/ 48 boph PB 3648 72/ 3626-44

S/ 6 boph 12 hr. S/ 6 boph 24 hr.

DP 3817 S/ 48 boph 3 hr.

Comp. 1137 bopd 37 bw

MAR 3 1952

Scout Cards	_____
Land Small Map	_____
Land Wall Map	_____
Tracings	_____
France Map	_____
France Map	_____

[Handwritten signature]