


O.W.W.O.

Section 35 Township 5 Range 29W

Well No. #1 Wachen Dofer

Company Henderson Oil
E. K. Carey

NORTH

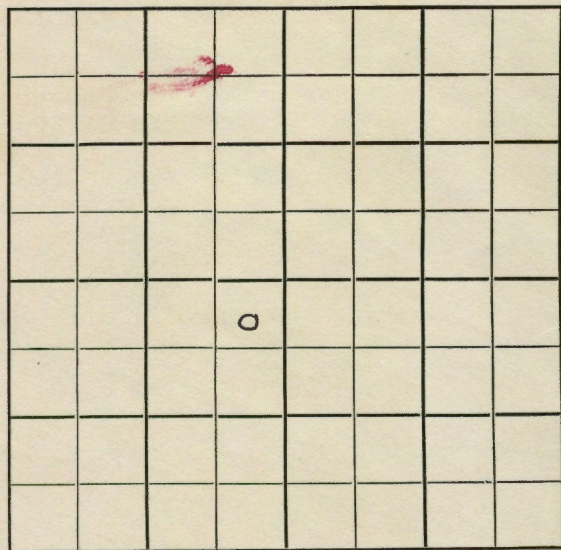

WEST

EAST

SOUTH

Sec. 35 Twp. 5 R. 29 W

Well No. #1 Wachen Dofer Farm

Henderson Oil
E. K. Carey Company

Peel Drlg. Contractor

Wildcat

330 Ft. from N. Line


_____ Ft. from S. Line

330 Ft. from E. Line

_____ Ft. from W. Line

NE NE SW

NORTH

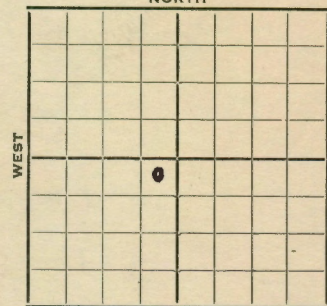

WEST

EAST

SOUTH

1952

Elev. 2811 REPORT

7/23

Location

7/30

"

8/6

8" @ 274'

Anhy 2570'

Drlg. 3135'

8/13

Heeb. 3890'

Dodge 3928

Drlg. 4375'

8/20

Spudding date 7-31-52

8" @ 274' Anhy 2570

Heeb. 3901 Lans. 3928

BKC 4146 Cong. 4443

Miss 4517 TD 4525

D&A **ABANDONED**

1954

O.W.W.O.

2/10

D & A TD 4525' Lans. 3928'

B KC 4146' OTD 4525' 5" @ 4180

12/4116-4120 20/4089-94 SO 1000 A

wtr. D & A

FIRST REPORT

ABANDONED

O.W.W.O.

County **Decatur** State **Kansas**

Sec. **35** (Blk. **5**) (Sur. **29W**) Map No.

Operator **Henderson Oil (was E.K. Carey)**

Well No. **1** Farm **Wachendofer**

Elev. Location **NE NE SW**

ABANDONED			
FIRST REPORT			

330 Ft. From **N** Line **SW**

330 Ft. From **E** Line Quarter

1st. Report **FEB 10 1954**

Completion **FEB 10 1954**

Remarks **OWO**

O.W.W.O.

Spudding Date

Drig. Data **D & A** **TD 4525**

Lens. 3928 B KC 4146 OTD 4525

5" @ 4180 12/ 4116-4120 20/ 4089-94

SO 1000 A str.

D & A

J. G. McGEHEE