


Section 17 Township 5 Range 30 W

Well No. # 1 Skiles


Company Derby Oil et al

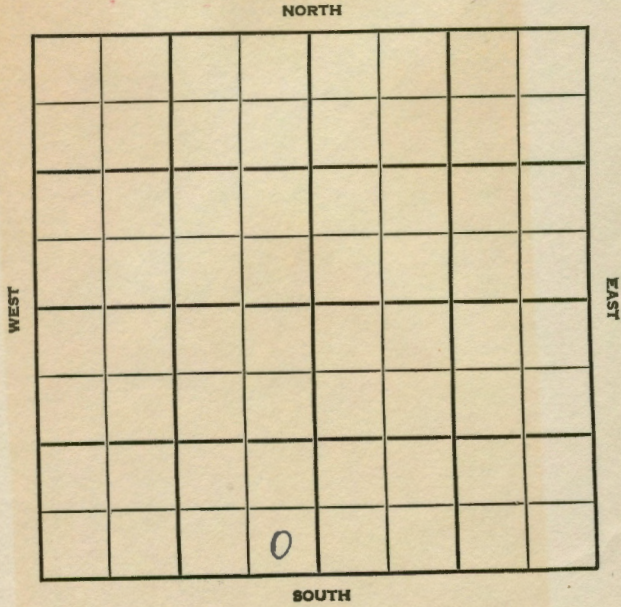

14

SEC. 17 TWP. 5 R. 30 W
 WELL NO. # 1 Skiles FARM
 COMPANY
Derby Oil et al
 CONTRACTOR

Schafer Drlg.
Wildcat
 _____ Ft. from N. Line
330 _____ Ft. from S. Line
330 _____ Ft. from E. Line
 _____ Ft. from W. Line
 SE SE SW

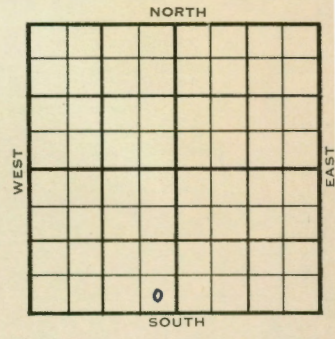

	ELEVATION	REPORT
1954	2913'	
9/22	Location	
10/20	D&A	
	TD 4600'	
	8" @ 348'	
	Howard 3741', Top 3764', Heeb 3915',	
	Tor. 3946'	
	DST 3948-4000', opn 1 hr., rec. 130'	
	muddy sw, 1005#	
	Lans 3965'	
	DST 4118-60', opn 45", rec. 15' VSOCM	
	510#	
	Marm. 4196', Miss 4485'	
	TD 4600'	
	Arb. 4578' ABANDONED	
	D&A	

ABANDONED

